


Cowley

Map No. Kansas Sec. 6 Twp. 31 R. 6E

Well No. #15 Eastman Farm

Texas Co Company

NORTH

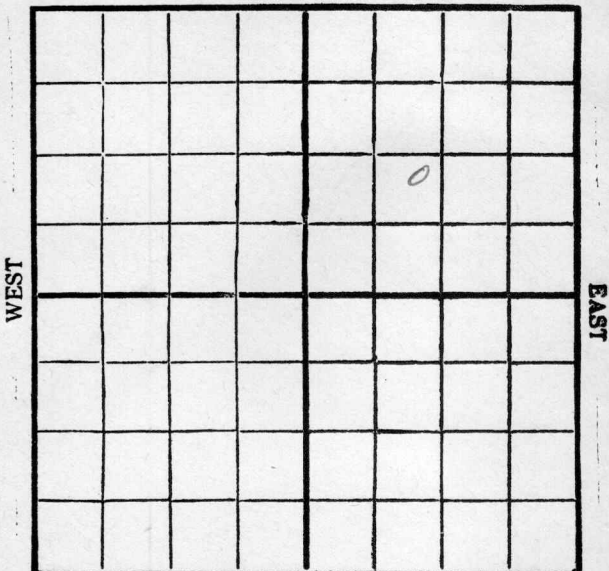

SOUTH

Location \_\_\_\_\_

Drilling Remarks \_\_\_\_\_

\_\_\_\_\_

\_\_\_\_\_

Rig Up \_\_\_\_\_

Drilling Remarks \_\_\_\_\_

\_\_\_\_\_

\_\_\_\_\_

RECORD

Cased \_\_\_\_\_ in. \_\_\_\_\_ ft.

Sand \_\_\_\_\_

Gas \_\_\_\_\_

Oil \_\_\_\_\_

Total Depth \_\_\_\_\_

PRODUCTION

1st 24 hrs. Nat. \_\_\_\_\_

1st 24 hrs. after shot \_\_\_\_\_

Gas \_\_\_\_\_ cu. ft.

Dry Hole \_\_\_\_\_

Abandoned \_\_\_\_\_


Map No. KANSAS Sec. 6 Twp. 3 R. 6<sup>E</sup>  
 Well No. 15 - Eastman Farm  
Texas Co. Company

\_\_\_\_\_ Ft. from N. Line

950 Ft. from S. Line

\_\_\_\_\_ Ft. from E. Line

950 Ft. from W. Line

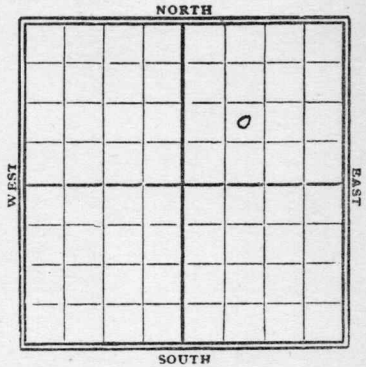

1929

Date

REPORT

Date	REPORT
4/10	Spdy.
7/17	Wdy
7/24	Spdy 200'
7/31	Wdy 685'
8/7	" 1450'
8/14	" 1808'
8/21	" 2020
8/28	" 2650'
9/4	sand 2866-76' dry very small show
9/11	sand 2866-78' shot 80 gts Est 10 bbl oil
9/18	
9/25	sand 2866-78' T.D. 2878' shot 80 gts 10 bbl oil Somp.

*Cowley*

*2*

Map No. KANSAS Sec. 6 Twp. 31 R. 6<sup>E</sup>

Well No. 15 Eastman

Texas Co Company

Contractor

**FIRST REPORTS**

**SECTION PLAT**

\_\_\_\_\_ Ft. from N. Line

950 Ft. from S. Line

\_\_\_\_\_ Ft. from E. Line

950 Ft. from W. Line

		o	
			•

Location \_\_\_\_\_

Rig up \_\_\_\_\_

Drilling and Remarks:

*Blog*

**RECORD**

Cased \_\_\_\_\_ in., \_\_\_\_\_ ft.

Sand \_\_\_\_\_

Gas \_\_\_\_\_

Oil \_\_\_\_\_

Total Depth \_\_\_\_\_

**PRODUCTION**

1st 24 hrs. Nat. \_\_\_\_\_

1st 24 hrs. after shot \_\_\_\_\_

Gas \_\_\_\_\_ Cu. Ft.

Dry Hole \_\_\_\_\_

Abandoned \_\_\_\_\_

Date

7/10/29

**CHAS. L. SHERWOOD**

19

Scout

*Cowley*

Map No. KANSAS Sec. 6 Twp. 31 R. 6

Well No. 15 Eastman

Texas Co

Company

Contractor

COMPLETE

SECTION PLAT

		o	

\_\_\_\_\_ Ft. from N. Line

950 Ft. from S. Line

\_\_\_\_\_ Ft. from E. Line

950 Ft. from W. Line

Location \_\_\_\_\_

Rig up \_\_\_\_\_

Drilling and Remarks:

80/10 Bls.

RECORD

Cased \_\_\_\_\_ in., \_\_\_\_\_ ft.

Sand 7866-7878

Gas \_\_\_\_\_

Oil \_\_\_\_\_

Total Depth 7878

PRODUCTION

1st 24 hrs. Nat. \_\_\_\_\_

1st 24 hrs. after shot \_\_\_\_\_

Gas \_\_\_\_\_ Cu. Ft.

Dry Hole \_\_\_\_\_

Abandoned \_\_\_\_\_

Date

SEP 25 1929

19 **CHAS. L. SHERWOOD**

Scout