


Cowley

Map No. *Ks* Sec. *6* Twp. *31* R. *6*
 Well No. *13 Eastman* Farm
Texas Co. Company

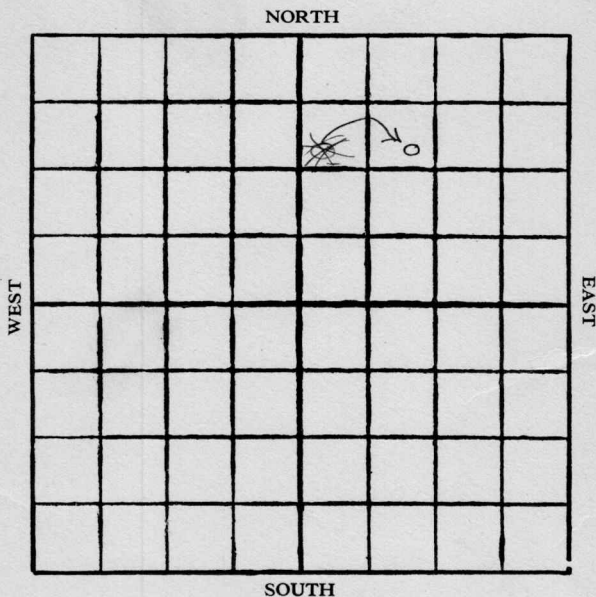

Location

Drilling Remarks

Rig Up

Drilling Remarks

RECORD

Cased in. ft.

Sand

Gas

Oil

Total Depth

PRODUCTION

1st 24 hrs. Nat.

1st 24 hrs. after shot

Gas cu. ft.


Dry Hole

Abandoned

Cowley

Map No. 1 Can Sec. 6 Twp. 31 R. 6Well No. 12 - Eastman FarmTexas Co. Company

NORTH

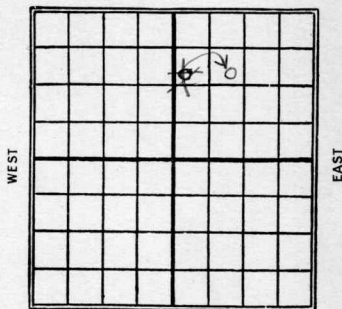

SOUTH

990

~~1070~~ Ft. from N. Line

Ft. from S. Line

Ft. from E. Line

890

~~250~~ Ft. from W. Line

1926

Date

REPORT

11/11 Rig up

11/17 same

11/23 Rign up

12/8 Drilg 990

12/15 " 1560'

12/22 " 1936

12/30 " 2410

1927

1/6 Topsand 2850 - setting 6"

1/12 Sand 2836-78

T.D. 2882 40 gte

50 bbls

2 KANSAS Cowley
 Map No. 6 Sec. 31 Twp. 6 R. 6

Well No. 13 Eastman

Texas Co. Company

Contractor

SECTION PLAT

1070 Ft. from N. Line

Ft. from S. Line

Ft. from E. Line

250 Ft. from W. Line

FIRST REPORTS

		0	

Location ✓

Rig up ✓

Drilling and Remarks:

RECORD

Cased _____ in., _____ ft.

Sand _____

Gas _____

Oil _____

Total Depth _____

PRODUCTION

1st 24 hrs. Nat. _____

1st 24 hrs. after shot _____

Gas _____ Cu. Ft.

Dry Hole _____

Abandoned _____

Date

NOV 11 1926

192

CHAS. L. SHERWOOD

Scout

Cowley

2 KANSAS 6 31 6
 Map No. Sec. Twp. R.
 Well No. 13 Eastman
 Texas Co. Company

Contractor

CORRECTION

SECTION PLAT

		6%	

990 Ft. from N. Line

Ft. from S. Line

Ft. from E. Line

890 Ft. from W. Line

Location

Rig up

Drilling and Remarks:

Rigged up
 chg hoe to
 chaves

RECORD

Cased _____ in., _____ ft.

Sand _____

Gas _____

Oil _____

Total Depth _____

PRODUCTION

1st 24 hrs. Nat. _____

1st 24 hrs. after shot _____

Gas _____ Cu. Ft.

Dry Hole _____

Abandoned _____

Date

NOV 23 1926

CHAS. L. SHERWOOD

192

Scout

Cowley

2 KANSAS

Map No.

Sec.

Twp.

R.

Well No.

Farm

Company

NORTH

COMPLETED

WEST

EASTP

990x 890

SOUTH

Location

Rig up

Drilling and Remarks:

40 50 Bb

RECORD

Cased 2 in., 20 ft.

Sand 2836-1878

Gas

Oil

Total Depth 288.2

PRODUCTION

1st 24 hrs. Nat.

1st 24 hrs. after shot

[illegible]

Dry Hole

Abandoned

Date
JAN 12 1927

CHAS. L. SHERWOOD

192

Scout