

KANSAS

Barton


Section 26 Township 20 Range 12WWell No. 1 GalliartCompany W. Black et al

Bryant

NORTH

WEST

EAST

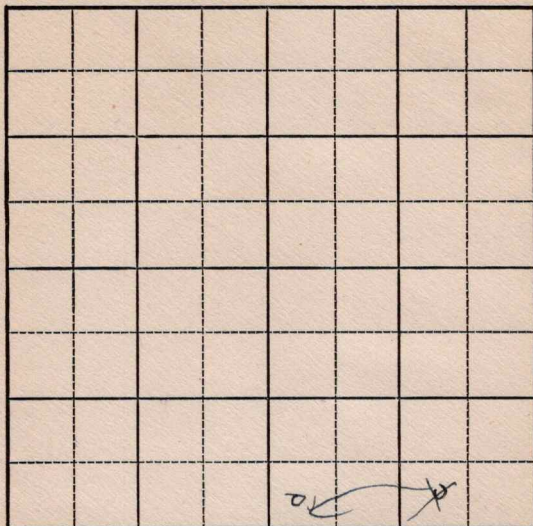

SOUTH

KANSAS

Barton



Sec. 26 Twp. 20 R. 12W

Well No. #1 Galliard Farm

W. Black et al Company


Bryant Pool

 Ft. from N. Line

330' Ft. from S. Line

990' Ft. from E. Line

330 Ft. from W. Line

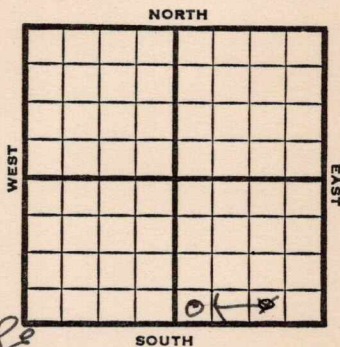

~~SW SE SE~~ *SW SE*

1949

Elev 1828'

R E P O R T

3/2 8" @ 230'

3/8 **Lans. 3140'**
Arb. 3369-73'

TD 3373'

5" @ 3370'

3/16 "

3/23 TD 3376'

1000 acid

Swb 12 bbls oil PH 10 hrs.

3/30 "

4/6 TD 3376'

Arb. 3369'

1000 acid

Pump 510 Oil Pot

41° Gr.

Comp

COMPLETED

Kansas

Bryant Pool

Map No. _____ Sec. 26 Twp. 20 R. 12WWell No. 1 GalliartW. Black et al. CompanyFIRST REPORT Contractor

SW SE SE

SECTION PLAT

_____ Ft. from N. Line

330 Ft. from S. Line990 Ft. from E. Line

_____ Ft. from W. Line

Barton County

Location _____

Rig up _____

Drilling and Remarks:

8" @ 230

RECORD

Cased _____ in., _____ ft.

Sand _____

Gas _____

Oil _____

Total Depth _____

PRODUCTION

1st 24 hrs. Nat. _____

1st 24 hrs. after shot _____

Gas _____ Cu. Ft.

Dry Hole _____

Abandoned _____

Date

MAR 2 1949

19

S. J. LEWIS

Scout

Kansas

Map No. _____ Sec. 26 Twp. 20 R. 12WWell No. 1 GalliartW. Black et al.

Company

CORRECTION

Contractor

SW SE

SECTION PLAT

_____ Ft. from N. Line

330 Ft. from S. Line

_____ Ft. from E. Line

330 Ft. from W. Line

Barton County

Location _____

Rig up _____

Drilling and Remarks:

Reported

SW SE SE

RECORD

Cased _____ in., _____ ft.

Sand _____

Gas _____

Oil _____

Total Depth _____

PRODUCTION

1st 24 hrs. Nat. _____

1st 24 hrs. after shot _____

Gas _____ Cu. Ft.

Dry Hole _____

Abandoned _____

Date

MAR 9 1949

19

S. J. LEWIS

Scout

Kansas


Map No. 46 Sec. 26 Twp. 20 R. 12WWell No. 1 Galliart

W. Black et al. Company

COMPLETE

Contractor

SW SE

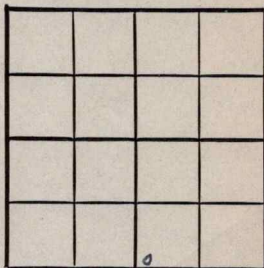E. 1828
SECTION PLAT Ft. from N. Line330 Ft. from S. Line Ft. from E. Line330 Ft. from W. Line

Barton County

Location Rig up

Drilling and Remarks:

*Oil & 3869**1000 acual**Pump 510 oil 188**4/28/46*

RECORD

Cased in., ft.Sand Gas Oil Total Depth 3876

PRODUCTION

1st 24 hrs. Nat. 1st 24 hrs. after shot Gas Cu. Ft.Dry Hole Abandoned

Date

APR 6 1949 19S. J. LEWIS Scout