


Section 26 Township 20 Range 12 W

Well No. # 5 Galliart

Company Black Cat Oil

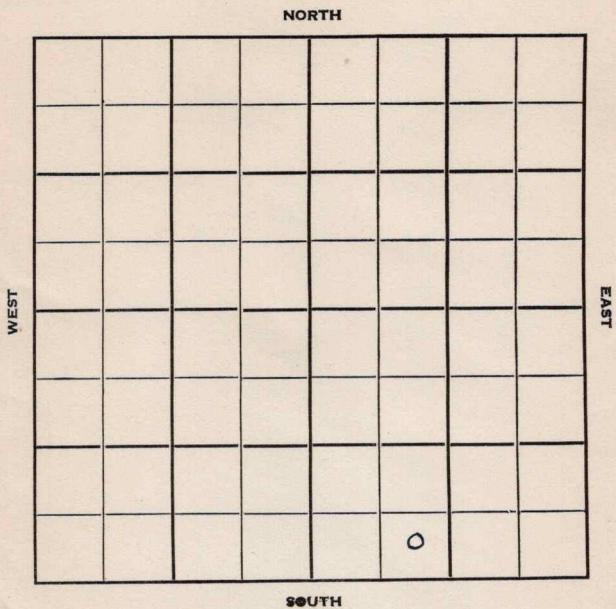

Barton

KANSAS

Sec. 26 Twp. 20 R. 12 W

Well No. # 5 Galliart Farm

Black Cat Oil Company

Black Cat Contractor

Bryant Pool


Ft. from N. Line

330 Ft. from S. Line

Ft. from E. Line

990 Ft. from W. Line

SE SW SE

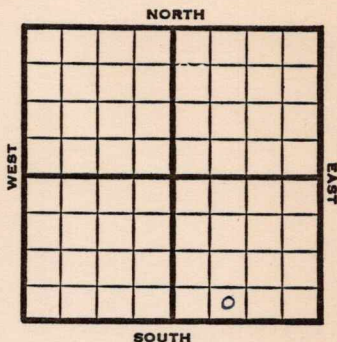

1951

Elev. 1830'

REPORT

5/23

Spud 5-18-51

8" @ 240' Anhy 595'

Drlg. 1543'

6/13

Spud 5-18-51

Oil well TD 3383' 8" @ 240

Anhy 595' Heeb 3003' Br. line 3134'

KC 3154' Arb. 3378-80

5" @ 3379 TD 3383' FU 1200' fluid

12 hr. S/2 BOPH 1000 A

Comp. 436 BOPD

COMPLETED

J. E. TYRA