


Section 33 Township 31 Range 6 E

Well No. # 4 C. F. Jarvis

Company Texas Company

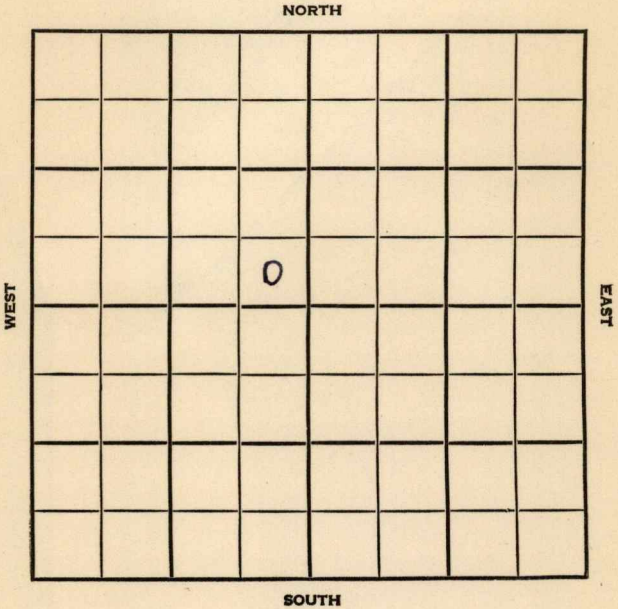

Cowley

KANSAS

SEC. 33	TWP. 31	R. 6E
------------	------------	----------


WELL NO. #4 C.F. Jarvis FARM

COMPANY Texas Company

CONTRACTOR Wakefield.

E. Burden Pool NORTH

\_\_\_\_\_ Ft. from N. Line  
 327 \_\_\_\_\_ Ft. from S. Line  
 303 \_\_\_\_\_ Ft. from E. Line  
 \_\_\_\_\_ Ft. from W. Line

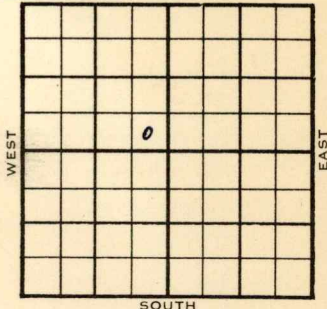

SE SE NW

1955	ELEVATION 1329'	REPORT
------	--------------------	--------

2/2 Spud 1-26-55  
 10" @ 120'  
 Drlg. 680'

2/23 Spud 1-26-55 D & A TD 3100  
 10" @ 120 Top. 1094 Stal. 1844  
 KC 2204 Layton 2239 Oswego 2651  
 Cherokee 2724 Bart 2859 Miss 2998  
 TD 3100 7" @ 2312 CO to 2279  
 19/2238-44 2 1/2 BSWPH S/44 BSW 24 hr.  
 CO to 2245 19/2238-44 dry 250 A  
 frac. Lost load. D & A

**ABANDONED**



County Cowley State Kansas

Sec. 33 (Blk. Twp.) 31 (Sur. Rge.) 6E Map No.

Operator Texas Company

Well No. 4 Farm C. F. Jarvis

Elev. 1329 Location SE SE NW



327 Ft. From S Line NW

303 Ft. From E Line Quarter

1st. Report

Completion FEB 23 1955

Remarks E. Burden Pool

Wakefield - Contr.

Spudding Date 1-26-55

Drlg. Data D & A TD 3100

10" @ 120 Top. 1094 Stal. 1844

KC 2204 Layton 2239 Oswego 2651

Cherokee 2724 Bart. 2859 Miss. 2998

TD 3100 7" @ 2312 CO to 2279

19/ 2238-44 2 1/2 bswph S/ 44 bsw 24 hr.

CO to 2245 19/ 2238-44 dry 250 A

frac lost load

D & A

FABEN GILSTRAP