

Cowley

KANSAS

SECTION 7 TOWNSHIP 31 RANGE 6E

WELL NO. #1 Eastman "B" # (D)

COMPANY McNeish & Gralapp

NORTH

				0			

WEST

EAST

SOUTH

Cowley

KANSAS

SEC. 7-	TWP. 31	R. 6E
------------	------------	----------

WELL NO. #1 Eastman ^B "p"

FARM

COMPANY McNeish & Gralapp

CONTRACTOR


Eastman

_____ Ft. from N. Line

_____ Ft. from S. Line

_____ Ft. from E. Line

_____ Ft. from W. Line

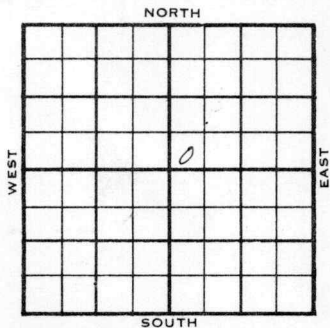

SW SW NE

1956	ELEVATION 1280'	REPORT
------	--------------------	--------

4-11 8" @ 80

5-2 5 1/2" @ 2784
 CO 2810, frac
 P/ 25 bopd, no/wtr.
 Bartl Zn 2771
 Bartl Sd 2783
 TD 2810'

COMPLETED

CORRECTION

FORM 513 SUNRAY

County Cowley Elev. 1280
 Sec. 7 Twp. 31 Rge. 6E
 Company McNeish & Gralapp
 Farm Name Eastman "B" No. 1

TOPS	DEPTH	LOG	DATUM	Loc. in Sec.
Anh.				SW SW NE
Tr.				SW SW NE
H.				SW SW NE
Tr. <u>13871 20 2771</u>			<u>1491</u>	
Dg. <u>" 50 2783</u>			<u>1503</u>	
Bl.				
L.				Geol.
K.C.				Contr.
B.K.C.				
Ce.				
C.				
M.				Pool
M.				<u>Eastman</u>
K.				
Mz.				
Me.				
V.				
S.				<div style="border: 1px dashed black; padding: 10px; display: inline-block;"> COMPLETE ○ </div>
S.				
A.				
R.				
Pe.				
G.				
T.D.	<u>2810</u>			

MAY 2 1956

Date Comm.

8" @ 80 APR 18 '56 APR 20 '56 5 1/2 @ 2784

MAY 2 '56 CO 2810 FRAC P. 25 Bopd

no/wtr.

Co. No. Sec. No. T. R.