

DX 78-1


Cowley

KANSAS

Section 34 Township 31 Range 6E

Well No. #1 Culp

Company E. F. Wakefield

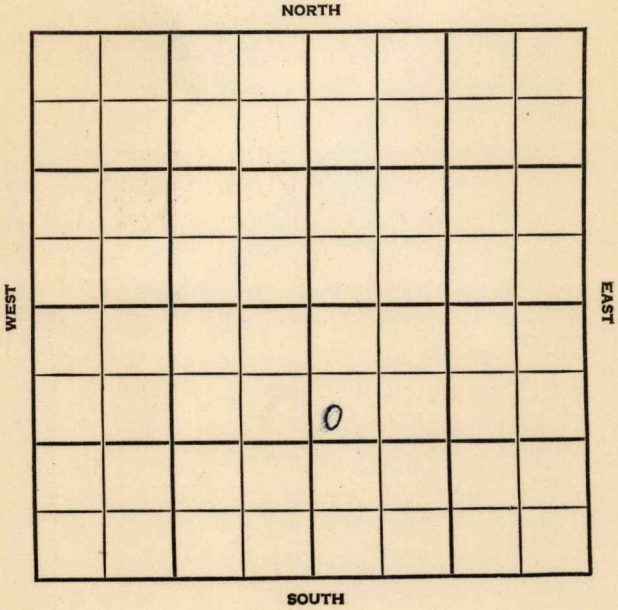

Cowley

KANSAS


SEC.	TWP.	R.
34	31	6E

WELL NO. **1 Culp** FARM

COMPANY **# E. F. Wakefield**

CONTRACTOR **Co. Tools**

_____ Ft. from N. Line
 _____ Ft. from S. Line
 _____ Ft. from E. Line
 _____ Ft. from W. Line

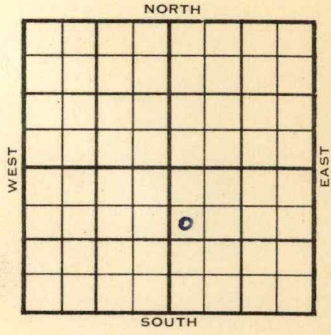

SW NW SE

1955	ELEVATION 1375	REPORT
------	-------------------	--------

6/15	10" @ 111	
6/29	Comm 6-17-55 Layton 2200 KC 2346 M 3088 TD 3115 10" @ 111 D & A	ABANDONED

County Cowley Elev. 1375
 Sec. 34 Twp. 31 Rge. 6E
 Company E. F. Wakefield
 Farm Name Culp No. 1

Co.

TOPS	DEPTH	LOG	DATUM
Anh.			
Tp.			
H.			
Tr.			
Dg.			
Bl.			
L. <u>aytan</u>	<u>2200</u>		<u>825</u>
M.C.	<u>2346</u>		<u>971</u>
B.K.C.			
Ce.			
C.			
M.	<u>3088</u>		<u>1713</u>
M.			
K.			
Mz.			
Me.			
V.			
S.			
S.			
A.			
R.			
Pe.			
G.			
T.D.	<u>3115</u>		<u>1740</u>

Loc. in Sec. SW NW SE

Geol. _____

Contr. _____

Co. tools _____

Pool _____

ABANDONED

0

Lse.

No.

Date Comm. 6-17-55 JUN 29 1955
 10" @ 111

Sec.

D & A

T.

R.

County Cowley ✓ Elev. _____
 Sec. 34 Twp. 81 Rge. 6E
 Company E. F. Wakefield
 Farm Name Culp No. 1

TOPS	DEPTH	LOG	DATUM	Loc. in Sec.
Anh.				SW NW SE
TP.				
H.				
Tr.				
Dg.				
Bl.				
L.				Geol. _____
K.C.				Contr. _____
B.K.C.				
Ce.				Co. tools
C.				
M.				Pool
M.				
K.				
Mz.				
Me.				
V.				
S.				
S.				
A.				
R.				
Pe.				
G.				
T.D.				

FIRST REPORT

JUN 15 '55

Date Comm. 10" @ 111

Co.
Lse.
No.
Sec.
T.
R.