


Section 7 Township 31 Range 6 E
Well No. # 1 Reising *(Rising)*
Company H. H. Blair & Ed Adair

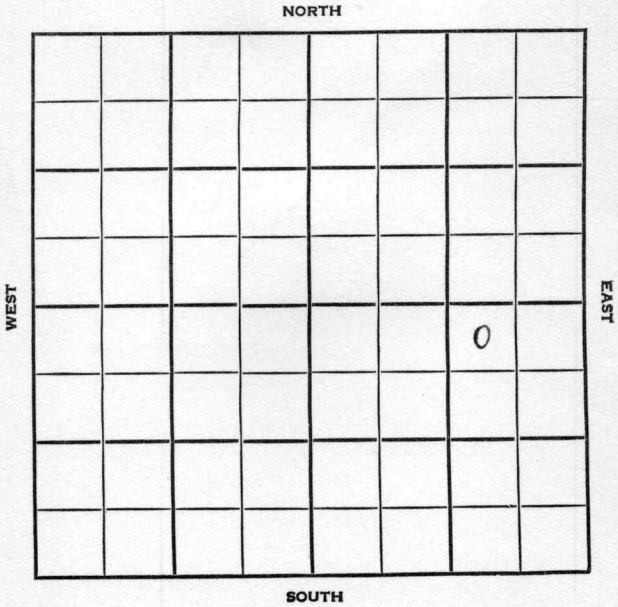

Cowley

KANSAS

SEC.	TWP.	R.
7	31	6E

WELL NO.

#1 Reising

FARM

COMPANY

H.H. Blair & Ed Adair.

CONTRACTOR


Eastman Pool

330 Ft. from N. Line

Ft. from S. Line

990 Ft. from E. Line

Ft. from W. Line

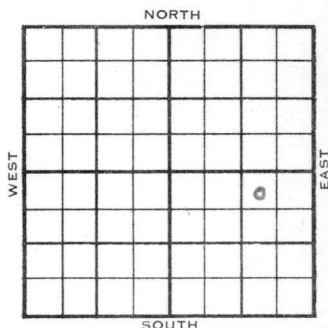

NW NE SE

1954

ELEVATION

1285'

REPORT

10/6

Location

11/3

Spud 10-13-54 - D&A

TD 3345'

8" @ 180'

Lans 1675', Stal. 1721', KC 2104',

B KC 2336', Big Lime 2414', Oswego

2488', Cherokee 2561', Bart 2726',

DST 2736-86', opn 1 hr., rec. 45' mud,
60#DST 2812-42', opn 1 hr., rec. 120' gas,
30' ocm, 130#

Miss 2832', Chatanooga 3285', Arb. 3314'

TD 3345'

D&A

ABANDONED

County Cowley State KansasSec. 7 (Blk.) 31 (Sur.) 6E Map No.Operator H. H. Blair & Ed AdairWell No. 1 Farm ReisingElev. Location NW NE SE

FIRST REPORT

330 Ft. From N Line SE990 Ft. From E Line Quarter1st. Report OCT 6 1954

Completion

Remarks

Spudding Date

Drlg. Data Eastman Pool

Location

FABEN GILSTRAP

County Cowley State Kansas
 Sec. 7 (Blk.) 31 (Sur.) 6E Map No.
 Operator H. H. Blair & Ed Adair
 Well No. 1 Farm Reising
 Elev. 1285 Location NW NE SE



330 Ft. From N Line SE
990 Ft. From E Line Quarter
 1st. Report
 Completion NOV 3 1954
 Remarks Eastman Pool

Sp/adding Date 10-13-54
 Drlg. Data D & A TD 3345

8" @ 180 Lans. 1675 Stal. 1721

KC 2104 B KC 2336 Big lime 2414

Oswego 2488 Cherokee 2561 Bart. 2726

DST 2736-86 open 1 hr. Rec. 45' mud

60# DST 2812-42 open 1 hr. Rec.

120' gas 30' ocm 130# Miss. 2832

Chatanooga 3285 Arb. 3314 TD 3345

D & A

FABEN GILSTRAP