FORM 51

Cowley KANSAS

Section 34 Township 31 Range 6E

Well No. 1 Davis

Company J. G. Ripstra (Omar Drlg.)

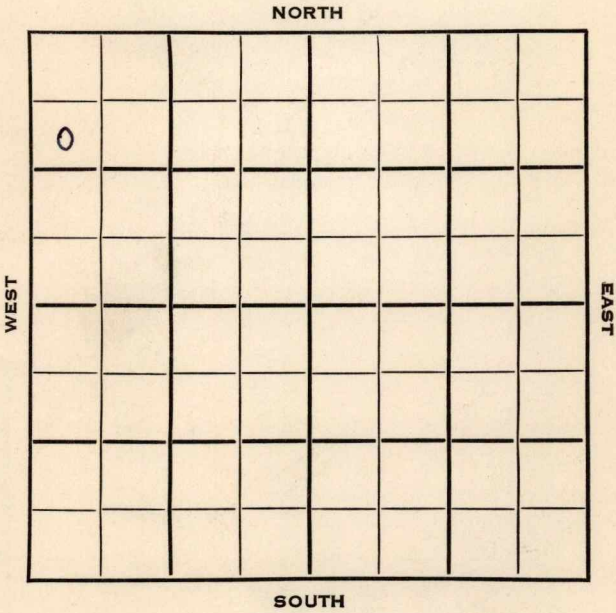

7366

Cowley KANSAS

SEC.	TWP.	R.
34	31	6 E

WELL NO.

1 Davis FARM

COMPANY

J. G. Ripstra (Omar Drlg.)

CONTRACTOR

Saturn Drlg.

990 Ft. from N. Line

Ft. from S. Line

Ft. from E. Line

330 Ft. from W. Line

SW NW NW

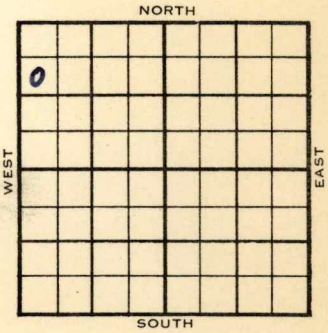

1953	ELEVATION ---- 1366 REPORT
11/4	Spud 11-2-53
11/18	Spud 11-2-53 D & A TD 3042 8" @ 80 Top. 1115 Stal. 1837 Layton 2218 KC 2344 Oswego 2651 DST 2653-73 open ½ hr rec 5' mud 115# Miss. 2990 TD 3042 D & A ABANDONED

DX-78

FORM 275 FOR SALE BY KANSAS BLUE PRINT CO.

County Cowley State Kansas

Sec. 34 (Blk. Twp.) 31 (Sur. Rge.) 6E Map No.

Operator J. G. Ripstra (Omar Drlg.)

Well No. 1 Farm Davis

Elev. Location SW NW NW

990 Ft. From N Line NW

330 Ft. From W Line Quarter

1st. Report

Completion NOV 18 1953

Remarks

Saturn Drlg. - Contr.

Spudding Date 11-2-53

Drlg. Data D & A TD 3042

8" @ 80 Top. 1115 Stal. 1837

Layton 2218 KC 2344 Oswego 2651

DST 2653-73 open ½ hr. Rec. 5' mud

115# Miss. 2990 TD 3042

D & A

J. G. McGEHEE

FORM 275 FOR SALE BY KANSAS BLUE PRINT CO.

County Cowley State Kansas

Sec. 34 (Blk. Twp.) 31 (Sur. Rge.) 6E Map No.

Operator J. G. Ripstra (Omar Drlg.)

Well No. 1 Farm Davis

Elev. Location SW NW NW

990 Ft. From N Line NW

330 Ft. From W Line Quarter

1st. Report NOV 4 1953

Completion

Remarks

Saturn Drlg. - Contr.

Spudding Date 11-2-53

Drlg. Data

J. G. McGEHEE