

Cowley

KANSAS

SECTION 7 TOWNSHIP 31 RANGE 6E

WELL NO. #2 Eastman "DW"

COMPANY McNeish & Gralapp

NORTH

					0		

WEST

EAST

SOUTH

Cowley

KANSAS

SEC.

7

TWP.

31

R.

6E

WELL NO.

#2 Eastman "D"

FARM

COMPANY

McNeish & Gralapp

CONTRACTOR

Watson

Eastman


_____ Ft. from N. Line

_____ Ft. from S. Line

_____ Ft. from E. Line

_____ Ft. from W. Line

NE SW NE

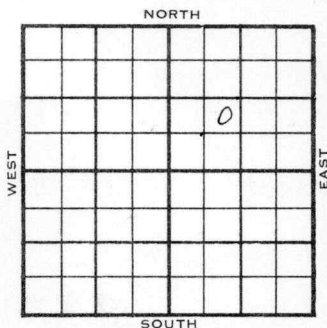

1956

ELEVATION

1286'

REPORT

5-2 WOR

5-29 Comm. 5-6-56
 8 5/8" @ 93 w/70
 5 1/2" @ 2792
 CO 2865

Frac, Lots wtr / SS0
 PB 2830

4" liner @ 2830

40/2808-18, frac

P/ 25 bopd, / 100 bwpd.

Bartl. 2788', Base 2848', M. 2863',
 TD 2865'.

COMPLETED

County Cowley Elev. _____
 Sec. 7 Twp. 31 Rge. 6E
 Company McNeish & Gralapp
 Farm Name Eastman "D" No. 2

TOPS	DEPTH	LOG	DATUM
Anh.			
Tp.			
H.			
Tr.			
Dg.			
Bl.			
L.			
K.C.			
B.K.C.			
Ce.			
C.			
M.			
M.			
K.			
Mz.			
Me.			
V.			
S.			
S.			
A.			
R.			
Pe.			
G.			
T.D.			

Loc. in Sec. _____

NE SW NE

Geol. _____

Contr. _____

Watson

Pool _____

Eastman

FIRST REPORT

MAY 2 '56

Date Comm. _____

W O R

MAY 2 1956

R. G.

Co.

Lse.

No.

Sec.

T.

R.

County Cowley Elev. 1286
 Sec. 7 Twp. 31 Rge. 6E
 Company McNeish & Gralapp
 Farm Name Eastman "D" No. 2

TOPS	DEPTH	LOG	DATUM	Loc. in Sec.
Anh.				NE SW NE
TP.				
H. <u>Bartl</u>	<u>2788</u>		<u>1502</u>	800SL
F. <u>Base</u>	<u>2848</u>		<u>1562</u>	
Dg.				100WL
Bl.				
L.				
K.C.				Geol.
B.K.C.				Contr.
Ce.				
C.				Watson
M.	<u>2863</u>		<u>1577</u>	
M.				Pool
K.				Eastman
Mz.				
Ma.				
V.				
S.				
S.				
A.				
R.				
PE.				
G.				
TD.	<u>2865</u>			



COMPLETE

Date Comm. MAY 29 1956
WOR MAY 9 '56 5-6-56 8 3/8 93/170
17 1520 MAY 16 '56 5 1/2 @ 2792/
WOCT MAY 20 '56 MAY 29 '56 CO 2865 Frac
Lots wta + 550 PB 2830 4"
Liner @ 2830 40/2808-18 Frac
P. 25 Bopd + 100 Bwpd.