

Cowley

Map No. *Kans* Sec. *8* Twp. *31* R. *6*

Well No. *1 - Scott* Farm


Brairie Oil & Gas Company

NORTH

(Stout)

WEST

EAST

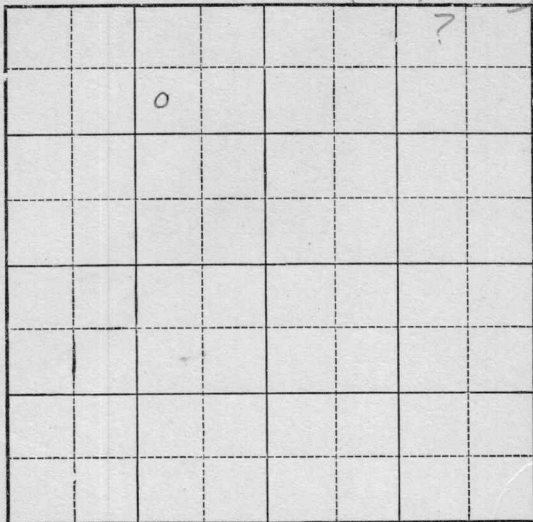

SOUTH

Location _____

Drilling Remarks

Rig Up _____

Drilling Remarks

RECORD

Cased _____ in. _____ ft.

Sand _____

Gas _____

Oil _____

Total Depth _____

PRODUCTION

1st 24 hrs. Nat. _____

1st 24 hrs. after shot _____


Gas _____ cu. ft.

Dry Hole _____

Abandoned _____

Map No. Kans 8 Sec. 8 Twp. 31 R. 6Well No. 1 Scott FarmPrairie Oil & G. Company

NORTH

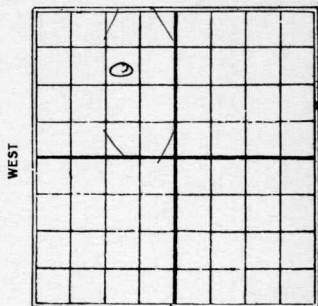990 Ft. from N. Line

Ft. from S. Line

990 Ft. from E. Line

Ft. from W. Line

SOUTH

1926

Date


REPORT

10/13 location10/27 drlg 200'11/4 same11/17 Drlg 170011/23 fishing 1775'12/8 Drlg 235512/15 Sand 2728' Drlg 2780' in sand, 1/2 m gas, no oil12/22 S.D. 283512/30 same19271/6 Sand 2728-27801/2 m gasD. & A. 2835J.D. 2835

Cowley

2 KANSAS 8 Twp. 31 R. 6

Well No. 1 *Scatt* Farm
Pravie of & So Co Company

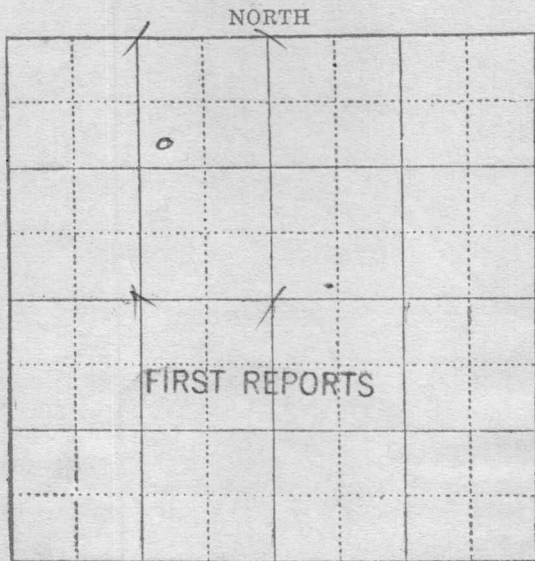

Location ☒

Rig up

Drilling and Remarks:

RECORD

Cased in., ft.

Sand

Gas

Oil

Total Depth

PRODUCTION

1st 24 hrs. Nat.

1st 24 hrs. after shot

Gas Cu. Ft.

Dry Hole

Abandoned

Date

OCT 13 1926

CHAS. L. SHERWOOD

Scout

Cowley
 2 KANSAS
 Map No. _____ Sec. *8* Twp. *31* R. *6*
 Well No. *1 Scott*
Haine Oil Co Company

Contractor

COMPLETED

SECTION PLAT

990 Ft. from N. Line

Ft. from S. Line

990 Ft. from E. Line

Ft. from W. Line

ABANDONED

Location _____

Rig up _____

Drilling and Remarks:

And 2728-2780
1/2 m 500

*DQ 5**2835*

RECORD

Cased _____ in., _____ ft.

Sand _____

Gas _____

Oil _____

Total Depth *2835*

PRODUCTION

1st 24 hrs. Nat. _____

1st 24 hrs. after shot _____

Gas _____ Cu. Ft.

Dry Hole ☒Abandoned ☒

Date

JAN 6 1927

CHAS. L. SHERWOOD

192

Scout