

Cowley Co.

Map No. _____ Sec. 8 Twp. 31 R. 6

Well No. 3 Stout Farm _____


Hosier & Deal Ltd. Company

_____ Ft. from N. Line

250' Ft. from S. Line

_____ Ft. from E. Line

200' Ft. from W. Line

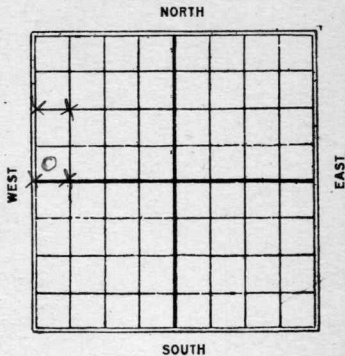

1925

Date	REPORT
10/1	Rig.
10/8	Rig.
10/16	Rig in up
10/22	spud
10/29	Running 15 1/2 @ 335'
11/6	drlg @ 900'
11-13	drlg 1270'
11-19	S/O 1404'
11/27	drlg 1432'
12/3	✓ 1475'
12/10	✓ 1850'
12/17	drlg 2315'
12/23	Drlg 2700'
12/31	S. O. 2700'
1926	
1/8	Sand 2740-2800' 1M gas Top line 2885' T. D. 2900' will try to shut in for gas well.
1/14	_____
1/20	plugged back to 2800'. will shoot.

1/27 - same

2/4 - _____

2/10 - _____

2/17 - Sand 2740-2800 P.B. 2800
T.D. 2900 5 1/2 ~~ft~~ Gas

Rowley Co
 31 R. 6

Map No. **KANSAS** Sec. **8** Twp. **31** R. **6**

Well No. **3 Stout**

Foster-Deal et al Company

Contractor

FIRST REPORTS

SECTION PLAT

----- Ft. from N. Line

750

----- Ft. from S. Line

----- Ft. from E. Line

700

----- Ft. from W. Line

<i>750</i>			

Location -----

Rig up -----

Drilling and Remarks:

RECORD

Cased ----- in., ----- ft.

Sand -----

Gas -----

Oil -----

Total Depth -----

PRODUCTION

1st 24 hrs. Nat. -----

1st 24 hrs. after shot -----

Gas ----- Cu. Ft.

Dry Hole -----

Abandoned -----

Date

OCT 1 1925

192

CHAS. L. SHERWOOD

Scout

Cowley Co

122 KANSAS

Map No. _____ Sec. 8 Twp. 31 R. 6

Well No. 3 Stout

East Deal et al Company

Contractor

COMPLETED

SECTION PLAT

_____ Ft. from N. Line

250 Ft. from S. Line

_____ Ft. from E. Line

200 Ft. from W. Line

o			

Location _____

Rig up _____

Drilling and Remarks:

top line 2885
20 2900'
plugged base to
2800'

120/5 1/2 in 26

RECORD

Cased _____ in., _____ ft.

Sand 2740-2800

Gas _____

Oil _____

Total Depth 2900'

PRODUCTION

1st 24 hrs. Nat. _____

1st 24 hrs. after shot _____

Gas 5 1/2 M Cu. Ft.

Dry Hole _____

Abandoned _____

Date

FEB 17 1926

CHAS. L. SHERWOOD