

Cowley


KANSAS

SECTION 9 TOWNSHIP 31 RANGE 6E

WELL NO. #1 Day

COMPANY Hartman

NORTH

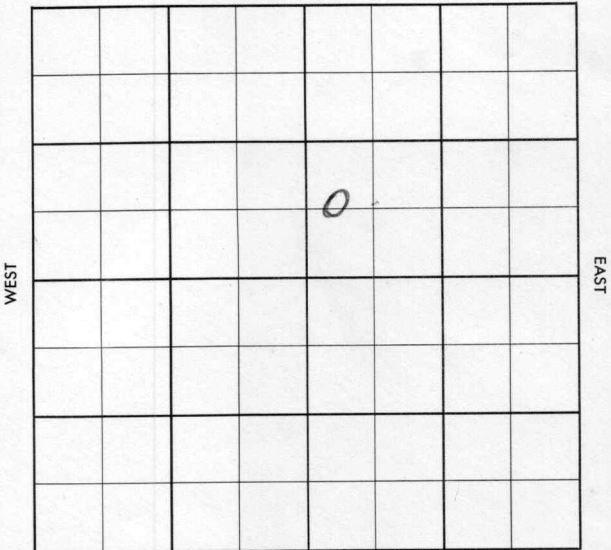

SOUTH

Cowley

KANSAS

SEC.

TWP.

R.

9

31

6E

WELL NO.

#1 Day

FARM

COMPANY

Hartman

CONTRACTOR


WILDCAT

Ft. from N. Line

Ft. from S. Line

Ft. from E. Line

Ft. from W. Line

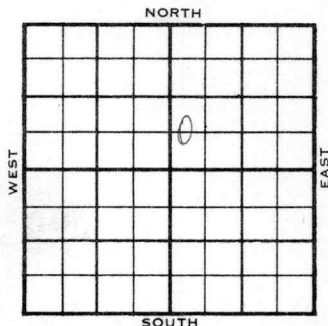C $W\frac{1}{2}$ SW NE

1956

ELEVATION

1393'

REPORT

5-16

MIR

5-29

Comm. 5-15-56

8 5/8" @ 97 w/100

D & A

KC. 2180', BKC 2398', Chbd 2426',
Marm 2484', Ce. 2624', M. Chat 2888',
M. Li. 2912', A. 3333'

TD 3370'

ABANDONED

Date Comm.
M I R

County CowleyElev. 1373Sec. 9Twp. 31Rge. 6ECompany HartmanFarmName DayNo. 1

TOPS	DEPTH	LOG	DATUM	Loc. in Sec.
Anh.				C W $\frac{1}{2}$ SW NE
Tr.				
Dg.				
Bl.				
L.				
K.C.	2180		787	Geol.
B.K.C.	2398		1005	Contr.
E. Chbd	2426		1033	
E. Marm	2484		1091	
M. ce	2624		1331	
M. chat	2885		1495	Pool
K. M. li	2912		1517	Wildcat
Mz.				
Mo.				
V.				
S.				
S.				
A	3333		1940	
R.				
Pe.				
G.				
TD	3370			

Date Comm.

MAY 29 1956

M I R MAY 23 '56

5-15-56 85/8

97/100

11 3123

MAY 29 '56

D&A