


Map No. KANSAS Sec. 11 Twp. 31 R. 6<sup>E</sup>

Well No. 1 Saturn Farm  
Mead Bros Company

**NORTH**

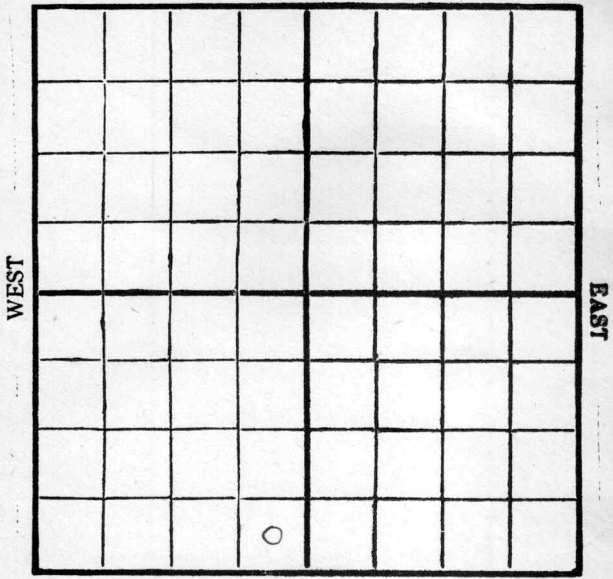

**SOUTH**

Location \_\_\_\_\_

Drilling Remarks \_\_\_\_\_

\_\_\_\_\_

\_\_\_\_\_

Rig Up \_\_\_\_\_

Drilling Remarks \_\_\_\_\_

\_\_\_\_\_

\_\_\_\_\_

**RECORD**

Cased \_\_\_\_\_ in. \_\_\_\_\_ ft.

Sand \_\_\_\_\_

Gas \_\_\_\_\_

Oil \_\_\_\_\_

Total Depth \_\_\_\_\_

**PRODUCTION**

1st 24 hrs. Nat. \_\_\_\_\_

1st 24 hrs. after shot \_\_\_\_\_

Gas \_\_\_\_\_ cu. ft.


Dry Hole \_\_\_\_\_

Abandoned \_\_\_\_\_

Map No. KANSAS Sec. 11 Twp. 31 R. 6<sup>E</sup>

Well No. 1- Tatum Farm  
Mead Bros Company

\_\_\_\_\_ Ft. from N. Line  
330 Ft. from S. Line  
330 Ft. from E. Line  
 \_\_\_\_\_ Ft. from W. Line

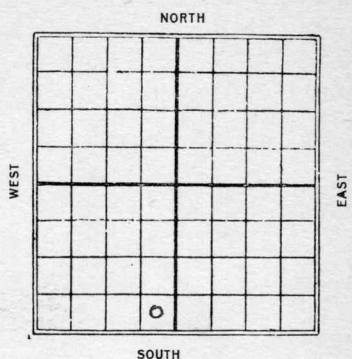

1929

Date	REPORT
10/2	Dry
10/19	2 Dry
10/16	Dry 900'
10/23	" 1325'
10/30	<u>S.D.</u> 1325'
11/6	—
11/13	—
11/20	Dry 1375'
11/27	" 1470'
12/4	" 1690'
12/11	" 1920'
12/23	<u>S.D.</u> 1920'
12/30	—
1930	—
1/8	—
1/15	—
1/22	—
1/29	—
2/4	—
2/11	<u>S.D.</u> 2000
2/19	—
2/26	—

3/5 - Orlg. 2020'

3/12 - " 2700'

3/19 - " 2916'

3/26 - Top Shot 2953'

S.P. 3100' T.D.

Dry & abandon

*Cowley*

Map No. KANSAS Sec. 11 Twp. 31 R. 6<sup>E</sup>

Well No. 1 Datum

Mead Bros Company

Contractor

FIRST REPORTS

SECTION PLAT

\_\_\_\_\_ Ft. from N. Line

330 Ft. from S. Line

330 Ft. from E. Line

\_\_\_\_\_ Ft. from W. Line


(Twin)

Location \_\_\_\_\_

Rig up

Drilling and Remarks:

RECORD

Cased \_\_\_\_\_ in., \_\_\_\_\_ ft.

Sand \_\_\_\_\_

Gas \_\_\_\_\_

Oil \_\_\_\_\_

Total Depth \_\_\_\_\_

PRODUCTION

1st 24 hrs. Nat. \_\_\_\_\_

1st 24 hrs. after shot \_\_\_\_\_

Gas \_\_\_\_\_ Cu. Ft.

Dry Hole \_\_\_\_\_

Abandoned \_\_\_\_\_

Date

OCT 2 1929

19

CHAS. L. SHERWOOD

Scout

