
Cowley KANSAS

SECTION 35 TOWNSHIP 31 RANGE 6E

WELL NO. #3 Culp

COMPANY Morrison Drlg.

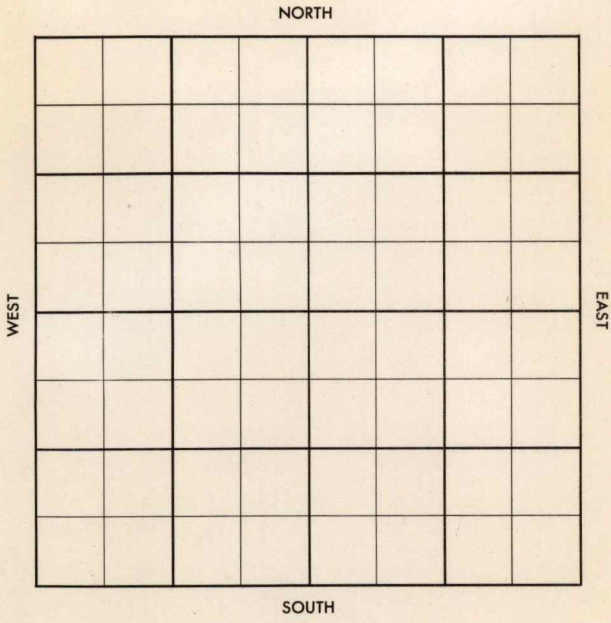

FORM 504-3 SUNRAY

Cowley KANSAS

SEC.	TWP.	R.
35	31	6E

WELL NO. #3 Culp FARM

COMPANY Morrison Drlg.

CONTRACTOR Co. Tools


Estes

_____ Ft. from N. Line

_____ Ft. from S. Line

_____ Ft. from E. Line

_____ Ft. from W. Line

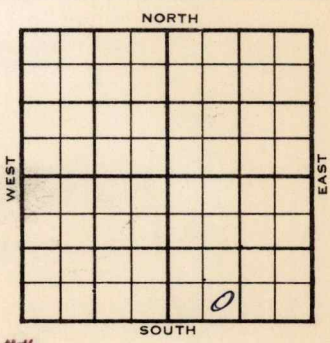

SE SW SE

SDX - Offset ##

1956	ELEVATION 1386'	REPORT
4-11	Comm. 4-7-56 8" @ 154 Drlg. 1780	
4-19	No report	
4-25	Cored 2172-2212, full rec.(silty sh&sh 5½" @ 1900 To make SWD well CO 80/ 1830-50, frac Complete SWD Well Lotan 1729 Stal 1812 Group 2136 Lay Horiz. 2174 L. Lay 2204-12 TD 2212'	

2174
1386
788

ABANDONED

DX-78

FORM 513 SUNRAY

County Cowley Elev.

Sec. 35 Twp. 31 Rge. 6E

Company Morrison Drlg.

Farm Name Culp No. 3

TOPS	DEPTH	LOG	DATUM
Anh.			
Tp.			
H.			
Tr.			
Dg.			
B.L.			
L.			
K.C.			
B.K.C.			
Ce.			
C.			
M.			
M.			
K.			
Mz.			
Mo.			
V.			
S.			
S.			
A			
R.			
P€.			
G.			
T.D.			

Loc. in Sec. SE SW SE

Geol.

Contr. Co. tools

Pool Estes



Date Comm. 4-7-56 SDX-OFFSET

8" @ 154 drlg. 1780

APR 17 1956

R. C.

Co. Lse. No. Sec. T. R.

FORM 513 SUNRAY

County Cowley Elev. 1386

Sec. 35 Twp. 31 Rge. 6E

Company Morrison Drlg.

Farm Name Culp No. 3

TOPS	DEPTH	LOG	DATUM
Anh.			
Tp. Iotan	1729		
H.			
Tr. Stall	1812		426
Dg.			
Bl.			
L.			
K.C. Group	2136		750
B.K.C.			
Ce. Lay Horiz	2174		788
C. L. Lay	2204-12		818
M.			
M.			
K.			
Mz.			
Me.			
V.			
S.			
S.			
A			
R.			
P€.			
G.			
T.D.	2212		

Loc. in Sec. SE SW SE

Geol.

Contr. Co. tools

Lse.

Pool Estes

ABANDONED

No.

Date Comm. 4-7-56 APR 25 1956

Sec.

8" @ 154 drlg. 1780 Cmd 2172.

-2212 Full rec (silty sh & shale)

5½ @ 1900 To make SWD well

APR 18 '56 APR 25 '56 CO 80/1830-50

Frac complete SWD well

T.

R.