


KANSAS

Barton

Section 26 Township 20 Range 12WWell No. 1 MarchandCompany Alpine Oil & Royalty

Bryant Pool

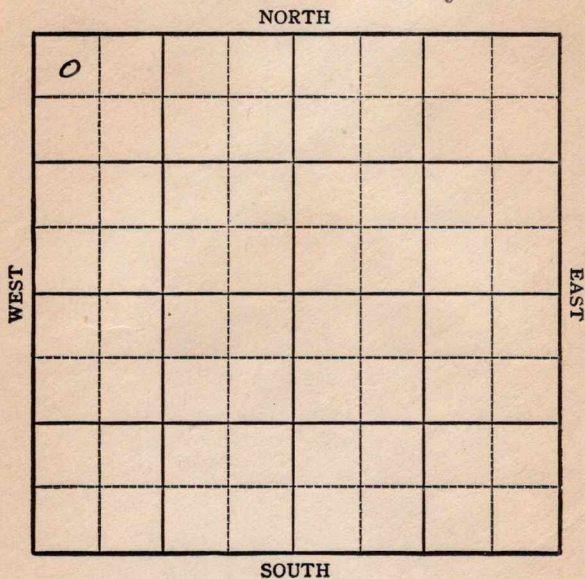



KANSAS

Sec. 26 Twp. 20 R. 12W

Well No. #1 Marchand Farm

Alpine Oil & Royalty Company

Bryant Pool


330' Ft. from N. Line

_____ Ft. from S. Line

_____ Ft. from E. Line

330' Ft. from W. Line

NW/C

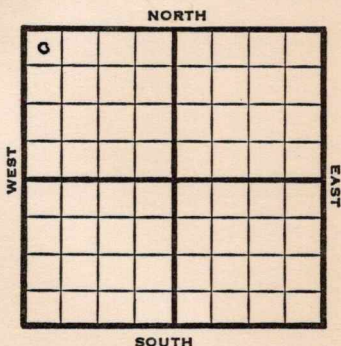

1948

Eli 1832'

R E P O R T

10/27

8" @ 229'

Anhy. 605'

Drlg. 2020'

11/3

Lansing 3140'

Arb. 3378-87'

TD 3387'

5"@ 3380'

11/10

TD 3385

2800' oil

500 acid

11/16

Swb 12 bbls oil PH

11/23

"

11/30

"

12/8

TD 3385'

Arb. 3378'

5"@ 3380'

500 acid

Pump 317 Oil Pot

40⁷ Gr.

Comp

COMPLETED

Map No. _____ Sec. 26 Twp. 20 R. 12W

Well No. 1 Marchand

Alpine Oil & Royalty Company

FIRST REPORT

NW/C Contractor


SECTION PLAT

330 Ft. from N. Line

_____ Ft. from S. Line

_____ Ft. from E. Line

330 Ft. from W. Line

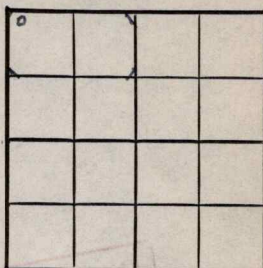

Barton County

Location _____

Rig up _____

Drilling and Remarks:

8" @ 229

Anhy 605

drlg. 2020

RECORD

Cased _____ in., _____ ft.

Sand _____

Gas _____

Oil _____

Total Depth _____

PRODUCTION

1st 24 hrs. Nat. _____

1st 24 hrs. after shot _____

Gas _____ Cu. Ft.

Dry Hole _____

Abandoned _____

Date

OCT 27 1948 19 S. J. LEWIS Scout

Kansas

Map No. 46 Sec. 26 Twp. 20 R. 12WWell No. 1 MarchandAlpine Oil & Royalty CompanyCOMPLETE


Contractor

NW/C

E1/832
SECTION PLAT330 Ft. from N. Line

Ft. from S. Line

Ft. from E. Line

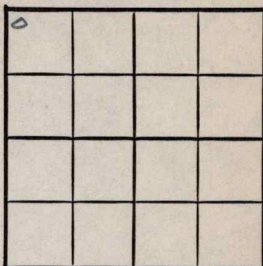330 Ft. from W. LineBarton County

RECORD

Location _____

Cased _____ in., _____ ft.

Rig up _____

Sand _____

Drilling and Remarks:

Gas _____

Oil ☒Total Depth 3380

PRODUCTION

1st 24 hrs. Nat. _____

1st 24 hrs. after shot _____

Gas _____ Cu. Ft.

Dry Hole _____

Abandoned _____

Date

DEC 8 1948 19S. J. LEWIS Scout