


KANSAS

Barton

Section 26 Township 20 Range 12WWell No. 1 Marchand "B"Company Texas

Bryant

NORTH

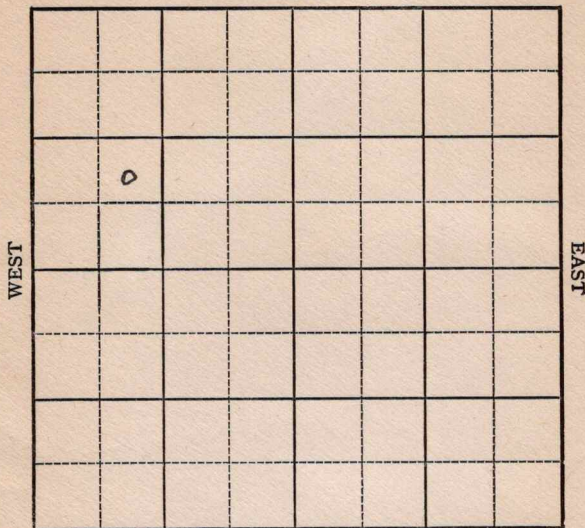

SOUTH

KANSAS

Barton

Sec. 26 Twp. 20 R. 12W ✓

Well No. #1 Marchand "B" Farm

Texas

Company


Bryant Pool

990' Ft. from N. Line

 Ft. from S. Line

 Ft. from E. Line

990' Ft. from W. Line

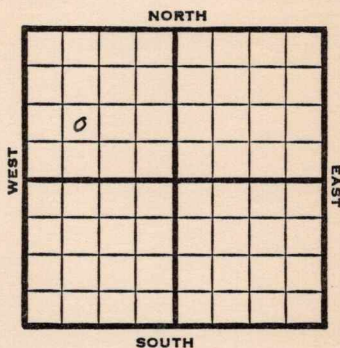

NE SW NW

1949

Elev 1821'

R E P O R T

4/6 Drlg. 709'
10" @ 597'

4/12 Drlg. 2887'

4/10 **Lansing 3127'** **Arbuckle 3357'**
TD 3361'
7" @ 3358'

4/27 "
5/4 TD 3366'

Arb. 3357'
7" @ 3358'
500 acid
Pump 456 Oil Pot
39' Gr.
Comp

COMPLETED

Map No. _____ Sec. 26 Twp. 20 R. 12W

Well No. 1 Marchand "B"

Texas Company

FIRST REPORT Contractor

NE SW NW

SECTION PLAT

990 Ft. from N. Line

_____ Ft. from S. Line

_____ Ft. from E. Line

990 Ft. from W. Line

Barton County

Location _____

Rig up _____

Drilling and Remarks:

drlg. 709

10" @ 597

RECORD

Cased _____ in., _____ ft.

Sand _____

Gas _____

Oil _____

Total Depth _____

PRODUCTION

1st 24 hrs. Nat. _____

1st 24 hrs. after shot _____

Gas _____ Cu. Ft.

Dry Hole _____

Abandoned _____

Date

APR 6 1949

19

S. J. LEWIS

Scout

Kansas

Map No. K 46 Sec. 26 Twp. 20 R. 12WWell No. 1 Marchand "B"

Texas

Company

COMPLETE

Contractor

NE SW NW

15.1821
SECTION PLAT

6			

990 Ft. from N. Line Ft. from S. Line Ft. from E. Line990 Ft. from W. Line

Barton County

Location Rig up

Drilling and Remarks:

2" @ 335'
5" @ 335'
Pump 456 oil
Pat

3935'

RECORD

Cased in., ft.Sand Gas Oil Total Depth 3936

PRODUCTION

1st 24 hrs. Nat. 1st 24 hrs. after shot Gas Cu. Ft.Dry Hole Abandoned

Date

MAY 4 1949

19

S. J. LEWIS

Scout