


Map No. KANSAS Sec. 15 Twp. 26 R. 2E
Well No. 1 - Mo Pac R.R. Farm
C. F. Jones Company

_____ Ft. from N. Line

810 Ft. from S. Line

490 Ft. from E. Line

_____ Ft. from W. Line

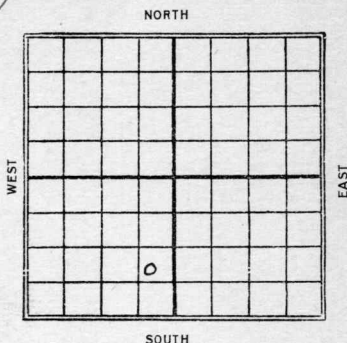

1929

Date REPORT

<u>8/28</u>	<u>Rig</u>
<u>9/4</u>	<u>Spud 80'</u>
<u>9/11</u>	<u>Wg 900'</u>
<u>9/18</u>	<u>W.R. 10" - 1454'</u>
<u>9/25</u>	<u>Wg 2140</u>
<u>10/2</u>	<u>" 2765'</u>
<u>10/9</u>	<u>Chat 2908-10'</u>
	<u>T.D. 2910'</u>
	<u>swab 250 bbls oil</u>
	<u>" 250 " water</u>
	<u>Comp.</u>

Map No. KANSAS Sec. 15 Twp. 26 R. 25

Well No. 1 Missouri Pacific RR

E. Jones Company

Contractor

SECTION PLAT

..... Ft. from N. Line

810 Ft. from S. Line

490 Ft. from E. Line

..... Ft. from W. Line

FIRST REPORTS

Location.....

Rig up.....

Drilling and Remarks:

Rig

RECORD

Cased..... in., ft.

Sand.....

Gas.....

Oil.....

Total Depth.....

PRODUCTION

1st 24 hrs. Nat.....

1st 24 hrs. after shot.....

Gas..... Cu. Ft.

Dry Hole.....

Abandoned.....

Date

AUG 28 1929

192.....

S. J. LEWIS

Scout

