


Map No. KANSAS Sec. 15 Twp. 26 R. 2^E

Well No. 1- Trip Farm
Penney et al Company

Lot 11 Blk 40 **NORTH** Greenwich Tst

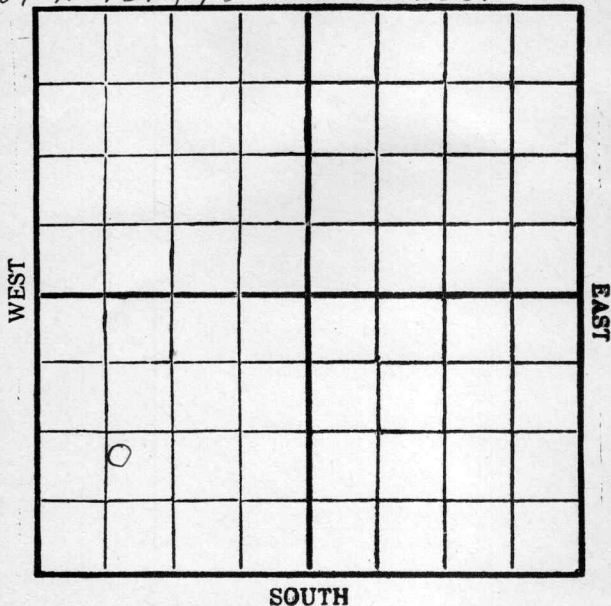

Location _____
Drilling Remarks _____

RECORD

Cased _____ in. _____ ft.
Sand _____
Gas _____
Oil _____
Total Depth _____


Rig Up _____
Drilling Remarks _____

PRODUCTION

1st 24 hrs. Nat. _____
1st 24 hrs. after shot _____
Gas _____ cu. ft. _____
Dry Hole _____
Abandoned _____

Map No. KANSAS Sec. 15 Twp. 26 R. 2^E
Well No. 1- Trupp Farm _____
Fenney et al Company _____

_____ Ft. from N. Line
1136 Ft. from S. Line
_____ Ft. from E. Line
693 Ft. from W. Line

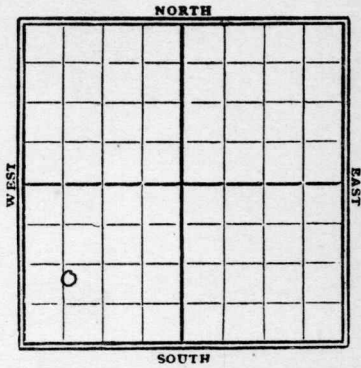

1929

Date	REPORT
7/24	Location
7/31	Rig up
8/7	Spdg 1600'
8/14	Wrlg 900'
8/21	- 2010'
8/28	.. 2660
9/4	2865
9/11	Chat 2940-42'
	T.D. 2942'
	swab 855 bbl oil 24 hrs.
	7 bbl water per hr.
	Comp.

Bedgwick
 Map No. KANSAS Sec. 15 Twp. 26 R. 26

Well No. 1 Tripp

Kenney & Co Company

Lot 1 Block 4 Contractor

Greenwich Township SECTION PLAT

.....Ft. from N. Line

1136 Ft. from S. Line

.....Ft. from E. Line

693 Ft. from W. Line

FIRST REPORTS

0			

Location ✓

Rig up

Drilling and Remarks:

RECORD

Cased in., ft.

Sand

Gas

Oil

Total Depth

PRODUCTION

1st 24 hrs. Nat.

1st 24 hrs. after shot

Gas Cu. Ft.

Dry Hole

Abandoned

Date

JUL 24 1929

192

S. J. LEWIS

Scout

Map No. KANSAS Sec. 15 Twp 26 R. 2E

Well No. 1 Tripp

Kennedy & Co Company

Lot 8 Block 4 Contractor

Greenwich Township

SECTION PLAT

.....Ft. from N. Line

1136 Ft. from S. Line

.....Ft. from E. Line

699 Ft. from W. Line

COMPLETED

0			

Location.....

Rig up.....

Drilling and Remarks:

Chas 2940-42

Swath 8558 1/2

788 lb water per hr

RECORD

Cased.....in.,ft.

Sand.....

Gas.....

Oil.....

Total Depth 2942

PRODUCTION

1st 24 hrs. Nat.....

1st 24 hrs. after shot.....

Gas.....Cu. Ft.

Dry Hole.....

Abandoned.....

Date

SEP 11 1929

S. J. LEWIS

192

Scout