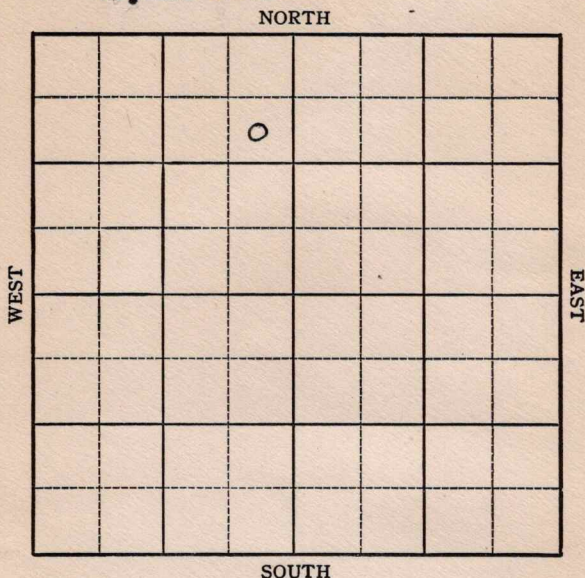


KANSASSection 26 Township 20 Range 12-WWell No. #4 MarchandCompany Alpine Oil & Royalty
Bryant Pool

KANSAS

Barton

Sec. 26 Twp. 20 R. 12W ✓

Well No. 4 Marchand Farm

Alpine Oil & Royalty Company
Bryant Pool


990 Ft. from N. Line

 Ft. from S. Line

330 Ft. from E. Line

 Ft. from W. Line

SE NE NW

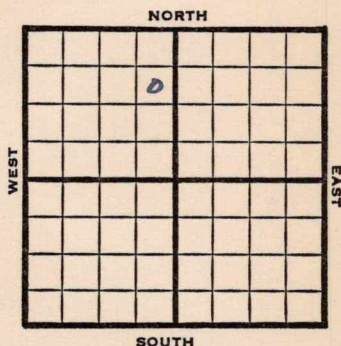

1949	Elev 1811'	REPORT
8/24	8" @ 260 Anhy 575' Drlg. 1215'	
8/31	Arbuckle 3354' TD 3356'	
9/7	5" @ 3355' TD 3384' 1500 acid Swb 1½ bbls oil PH	
9/14	"	
9/21	"	
9/28	"	
10/5	"	
10/12	"	
10/19	TD 3384' Arb. 3354' 5"@ 3355' 1500 acid Pump 40 Oil Pot 407 Gr. Comp	
	COMPLETED	

Kansas

Map No. _____ Sec. 26 Twp. 20 R. 12WWell No. 4 MarchandAlpine Oil & Royalty

Company

Contractor

SE NE NW

FIRST REPORT
SECTION PLAT990

Ft. from N. Line

Ft. from S. Line

330

Ft. from E. Line

Ft. from W. Line

Barton County

RECORD

Location _____

Cased _____ in., _____ ft.

Rig up _____

Sand _____

Drilling and Remarks:

Gas _____

Oil _____

Total Depth _____

8" @ 260

Anhy 575

drlg. 1215

PRODUCTION

1st 24 hrs. Nat. _____

1st 24 hrs. after shot _____

Gas _____ Cu. Ft.

Dry Hole _____

Abandoned _____

Date

AUG 24 1949 19S. J. LEWIS Scout

Kansas

Bryant Pool

Map No. _____ Sec. 26 Twp. 20 R. 12WWell No. 4 MarchandAlpine Oil & Royalty

Company

COMPLETE

Contractor

SE NE NW

E. 1. 1971
SECTION PLAT990


Ft. from N. Line

Ft. from S. Line

330

Ft. from E. Line

Ft. from W. Line

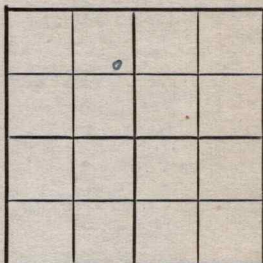Barton County

Location _____

Rig up _____

Drilling and Remarks:

*Cr X3354**5" casing**1500 casing**Run 40 oil Pst**402 ft*

RECORD

Cased _____ in., _____ ft.

Sand _____

Gas _____

Oil _____

Total Depth 2384

PRODUCTION

1st 24 hrs. Nat. _____

1st 24 hrs. after shot _____

Gas _____

Cu. Ft.

Dry Hole _____

Abandoned _____

Date

OCT 19 1949

19

S. J. LEWIS

Scout