

KANSAS

Barton


Section 26 Township 20 Range 12WWell No. 2 Marchand "B"Company Texas

Bryant

NORTH

WEST

EAST

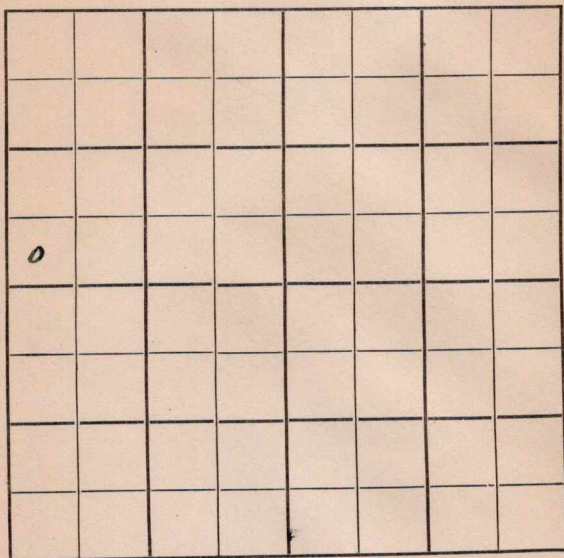

SOUTH

KANSAS

Barton

Sec. 26 Twp. 20 R. 12W ✓

Well No. #2 Marchand "B" Farm

Texas

Company

Bryant Pool


 Ft. from N. Line

330' Ft. from S. Line

 Ft. from E. Line

330' Ft. from W. Line

SW NW

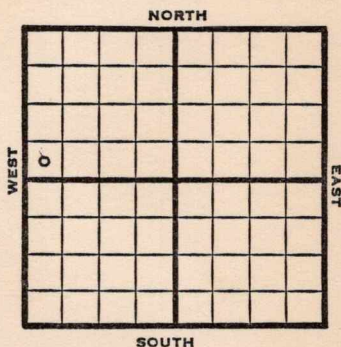

1949

Elev 1824'

R E P O R T

4/27 10" @ 601'

5/4 Drlg. 3213'

5/10 **Arb. 3365**

5" @ 3366

TD 3378'

1200' fluid

5/18 TD 3378'

Arb. 3365'

5" @ 3366'

Pump 453 Oil Pot

358 Gr.

Comp

COMPLETED

Kansas

Map No. _____ Sec. 26 Twp. 20 R. 12WWell No. 2 Marchand "B"

Texas

Company _____

FIRST REPORT

Contractor _____

SW NW

SECTION PLAT

_____ Ft. from N. Line

330 Ft. from S. Line

_____ Ft. from E. Line

330 Ft. from W. Line

Barton County

Location _____

Rig up _____

Drilling and Remarks:

10" @ 601

RECORD

Cased _____ in., _____ ft.

Sand _____

Gas _____

Oil _____

Total Depth _____

PRODUCTION

1st 24 hrs. Nat. _____

1st 24 hrs. after shot _____

Gas _____ Cu. Ft.

Dry Hole _____

Abandoned _____

Date

APR 27 1949

19

S. J. LEWIS

Scout

Map No. K46 Sec. 26 Twp. 20 R. 12W

Well No. 2 Marchand "B"

Texas Company

COMPLETE

Contractor

SW NW

E11824
SECTION PLAT

 Ft. from N. Line


330

 Ft. from S. Line

 Ft. from E. Line

330

 Ft. from W. Line

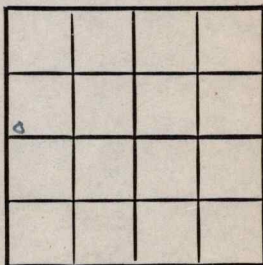

Barton County

Location

Rig up

Drilling and Remarks:

CR 3365

5" CR 3366

Run 453 oil Rod

39 54

RECORD

Cased in., ft.

Sand

Gas

Oil

Total Depth 2325

PRODUCTION

1st 24 hrs. Nat.

1st 24 hrs. after shot

Gas Cu. Ft.

Dry Hole

Abandoned

Date

MAY 18 1949 19

S. J. LEWIS

Scout