


Cowley

SECTION 36 TOWNSHIP 31 RANGE 6E

WELL NO. #5 Brooks

COMPANY Ayesh Oil

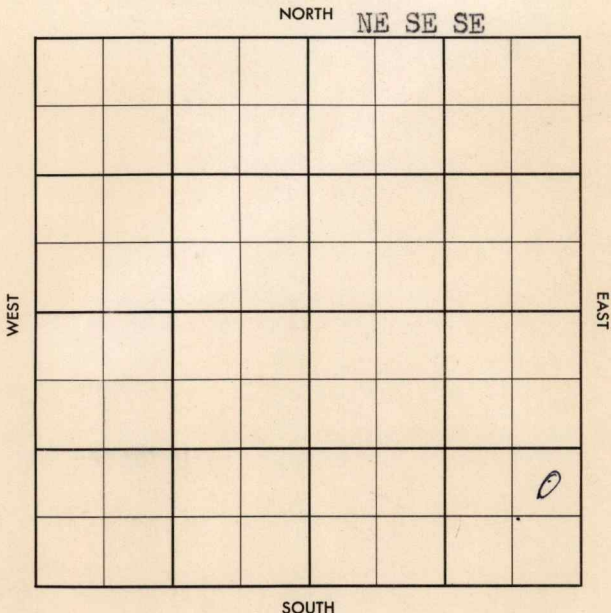

County Cowley Elev. \_\_\_\_\_  
 Sec. 36 Twp. 31 Rge. 6E  
 Company Ayesh Oil  
 FarmName Brooks No. 5

TOPS	DEPTH	LOG	DATUM	Loc. in Sec.
Anh.				NE SE SE
TP.				
H.				
Tr.				
Dg.				
Bl.				
L.				
K.C.				Geol. _____
B.K.C.				Contr. _____
Ce.				<u>Se-Ro-Bee</u>
C.				Pool <u>Burden</u>
M.				<u>Townsite</u>
M.				
K.				
Mz.				
Mq.				
V.				
S.				
S.				
A.				FIRST REPORT
R.				
PE.				FEB 6 '57
G.				
T.D.				

Date Comm. \_\_\_\_\_  
 Location \_\_\_\_\_

\_\_\_\_\_  
 \_\_\_\_\_  
 \_\_\_\_\_  
 \_\_\_\_\_  
 \_\_\_\_\_  
 \_\_\_\_\_

Co.  
Lse.  
No.  
Sec.  
T.  
R.

~~30~~

1365 DF

County Cowley Elev. 1365 RB  
 Sec. 36 Twp. 31 Rgs. 6E  
 Company Ayesh Oil  
 Farm Name Brooks No. 5

TOPS	DEPTH	LOG	DATUM	Loc. in Sec.
Anh.				NE SE SE
Tr.				700' FSL - 350' FEL
Dg.				
Bl.	1678*			
L.	stall 1709			
K.C.	LS9 1872			Geol.
B.K.C.	12741 2091			Contr.
Ce.	" sd 2153			Se-Ro-Bee
M.				Pool Burden
M.				Townsite
K.				
Mz.				
Mq.				
V.				
S.				
S.				
A.				
R.				
Pe.				
G.				
T.D.	2200			

COMPLETE  
 MAR 13 '57

Date Comm. Location FEB 13 '57 ✓ FEB 20 '57 2-16-57  
8" 102/100 D 640 FEB 27 '57  
5 1/2 2200 WEST MAR 6 '57 CO 16/  
2161-65 FRAC Fluid 27 B0 +  
5 BW 1hr MAR 13 '57 P 2500 + 5BW