


Section 17 Township 26 Range 2 E

Well No. #1 Tjaden "B"

Company J. P. Gaty

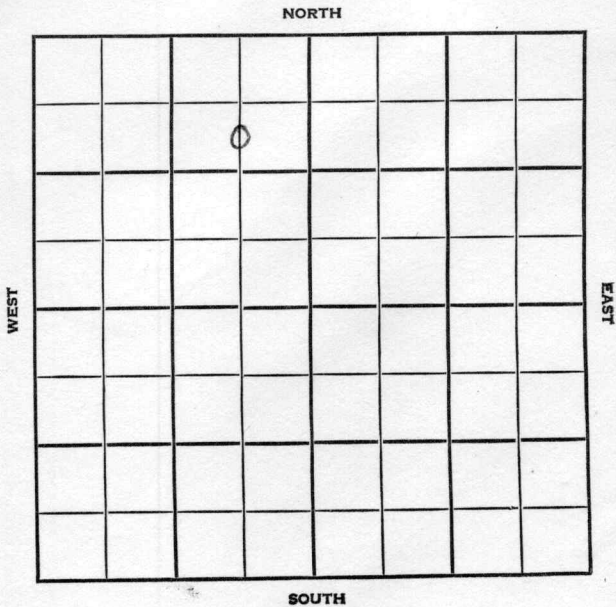

SEC. 17	TWP. 26	R. 2E
------------	------------	----------

WELL NO. #1 Tjaden "B" FARM

COMPANY J.P. Gaty

CONTRACTOR


S.Fairview

_____ Ft. from N. Line

_____ Ft. from S. Line

_____ Ft. from E. Line

_____ Ft. from W. Line

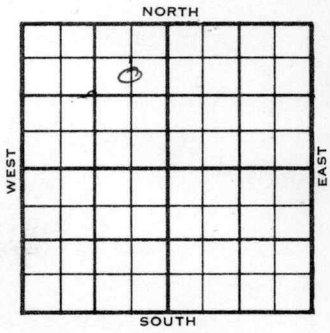

C S $\frac{1}{2}$ NE NW

1956	ELEVATION	REPORT
------	-----------	--------

2-29 Location

County **Sedgwick** Elev. **1425**
 Sec. **17** Twp. **26** Rge. **2E**
 Company **J. P. Gaty**
 Farm Name **Tjaden "B"** No. **1**

TOPS	DEPTH	LOG	DATUM	Loc. in Sec.	
Anh.				C S¹/₂ NE NW	
Tp.	
H.	
Tr.	
Dg.				Geol.	
Bl.				Contr.	
L.				Pool	
K.C.				S. Fairview	
B.K.C.	
Ce.				<table border="1"> <tr> <td></td> <td></td> <td></td> <td></td> </tr> <tr> <td></td> <td></td> <td></td> <td></td> </tr> <tr> <td></td> <td></td> <td></td> <td></td> </tr> <tr> <td></td> <td></td> <td></td> <td></td> </tr> <tr> <td></td> <td></td> <td></td> <td></td> </tr> <tr> <td></td> <td></td> <td></td> <td></td> </tr> <tr> <td></td> <td></td> <td></td> <td></td> </tr> <tr> <td></td> <td></td> <td></td> <td></td> </tr> <tr> <td></td> <td></td> <td></td> <td></td> </tr> <tr> <td></td> <td></td> <td></td> <td></td> </tr> </table>	
C.	
M.	
M.	
K.	
Mz.	
Mq.	
V.	
S.	
S.	
A	
R.	
Pe.	
G.	
T.D.	

FIRST REPORT
 FEB 29 1950

Date Comm. _____
 Location _____

Co.
 Lse.
 No.
 Sec.
 T.
 R.