

KANSAS


Bulter

FORM 51 5M 1-42 PETROL

Section 34 Township 27 Range 6-E

Well No. #3 ~~V~~ondenberg

Company J. J. Lynn

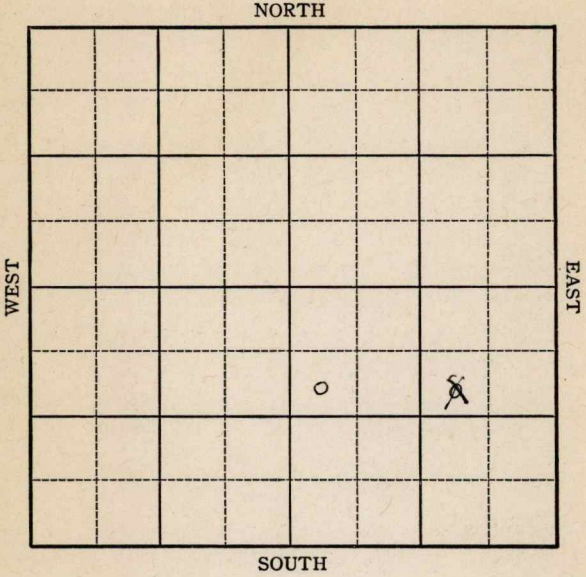

KANSAS

Bulter

Sec. 34 Twp. 27 R. 6-E

Well No. #3 Vandenberg Farm

J. J. Lynn Company

Miscellaneous


990 Ft. from N. Line

_____ Ft. from S. Line

_____ Ft. from E. Line

330 Ft. from W. Line

Elev. 1426

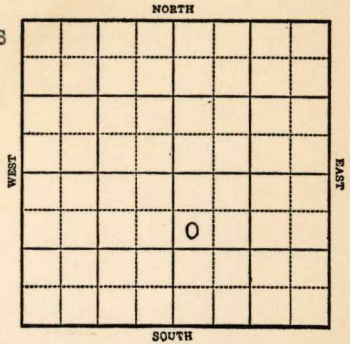

1943

R E P O R T

3/24

Cellar.

3/31

"

4/14

Lans 1700

KC 2115

T.D. 2183'

Water

ABANDONED

Butler

KANSAS

Map No. // Sec. 34 Twp. 27 R. 6E

Well No. 3 Bandonberg

J. J. Lynn Company

FIRST REPORT Contractor

SW NW SE

SECTION PLAT

990 Ft. from N. Line

Ft. from S. Line

Ft. from E. Line

330 Ft. from W. Line

		o	

MISCELLANEOUS

Location

Rig up

Drilling and Remarks:

Cellar

RECORD

Cased in, ft.

Sand

Gas

Oil

Total Depth

PRODUCTION

1st 24 hrs. Nat.

1st 24 hrs. after shot

Gas Cu. Ft.

Dry Hole

Abandoned

Date

MAR 24 1943

19

S. J. LEWIS

Scout

