


Section 17 Township 26 Range 2-E

Well No. #1 Joe Tjaden

Company J P Gatty

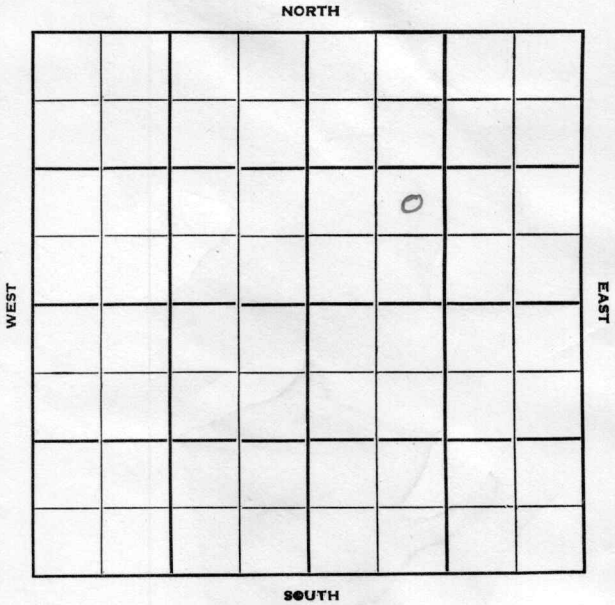

KANSAS

Sedgwick
2-E ✓

17

26

Sec. _____ Twp. _____ R. _____

Well No. #1 Joe Tjaden Farm

J. P. Gatty Company

Morrison Drlg.-Contr Contractor

Wildcat

_____ Ft. from N. Line

NORTH


990

_____ Ft. from S. Line

_____ Ft. from E. Line

990

_____ Ft. from W. Line

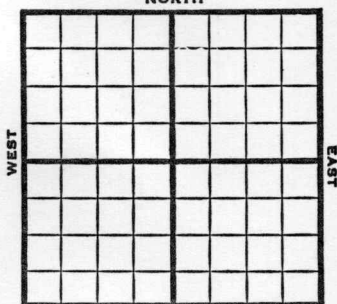

SOUTH

1950

Elev 1398'

REPORT

11/15

Drlg.

1951

1/10

Burgess 2945-47


5" @ 2945

TD 2950

Comp 32 bopd

Completed

COMPLETED

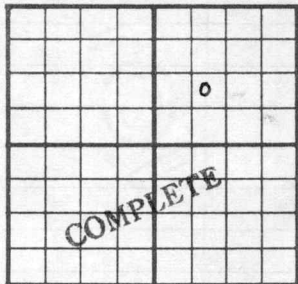County Sedgwick State KansasSec. 17 (Blk.
Twp.) 26 (Sur.
Rge.) 2E Map No.Operator J. P. GattyWell No. 1 Farm Joe TjadenElev. 1400 Location NE SW NE990 Ft. From S Line NE990 Ft. From W Line Quarter

1st. Report

Completion JAN 10 1961Remarks WildcatMorrison Drlg. - Contr.

Spudding Date

Drlg. Data Oil well TD 2950Burgess 2945-47 5" @ 2945 TD 2950Comp. 32 bopd

J. E. TYRA