


Section 17 Township 26 Range 2E

Well No. #2 Joe Tjaden

Company J. P. Gatty

NORTH

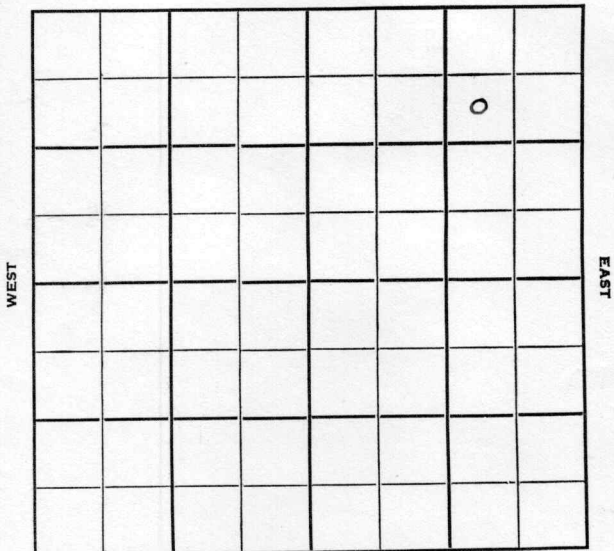

SOUTH

17

26

Sec. _____ Twp. _____ R. _____

Well No. #2 Joe Tjaden Farm _____

J P Gatty Company _____

Contractor _____


990 Ft. from N. Line

_____ Ft. from S. Line

990 Ft. from E. Line

_____ Ft. from W. Line

SW NE NE

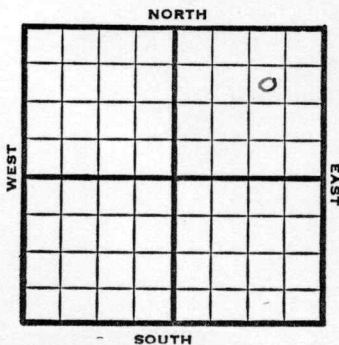

1950

REPORT

12/13

Location

1951

1/10

Spud 12-15-50

8" @ 98

Burgess 2935-39

5" @ 2935

TD 2981

1000 A

Comp for SWD well

Abandoned

ABANDONED

County **Sedgwick** State **Kansas**

Sec. **17** (Blk. Twp.) **26** (Sur. Rge.) **2E** Map No.

Operator **J. P. Gatty**

Well No. **2** Farm **Joe Tjaden**

Elev. **1398** Location **SW NE NE**

990 Ft. From **N** Line **NE**
 990 Ft. From **E** Line **Quarter**

1st. Report

Completion **JAN 10 1951**

Remarks

Spudding Date **12-15-50**

Drig. Data **SWD well** **TD 2981**

8" @ 98 **Burgess 2935-39** **5" @ 2935**

TD 2981 **1000 A** **Comp. for SWD well**

J. E. TYRA