


Section 18 Township 26 Range 2E

Well No. #1 Schramm

Company J. P. Gatty

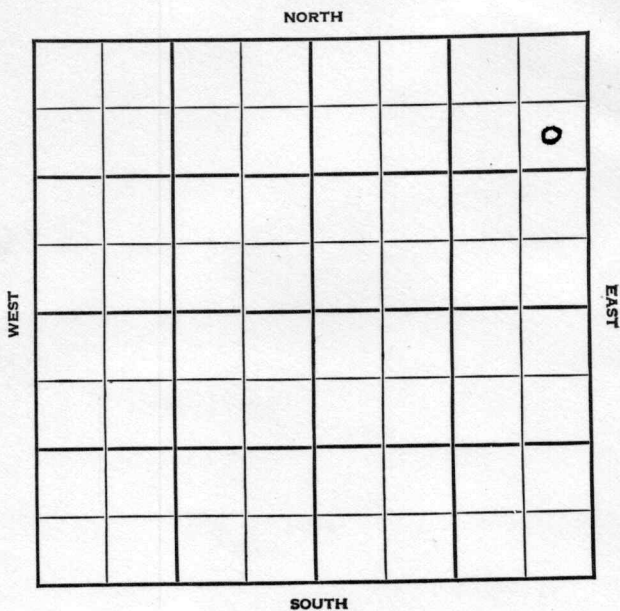

KANSAS

Sedgwick

Sec. 18 Twp. 26 R. 2E

Well No. #1 Schramm Farm

J. P. Gatty

Company

No Name


990' Ft. from N. Line

Ft. from S. Line

330' Ft. from E. Line

Ft. from W. Line

SE NE NE

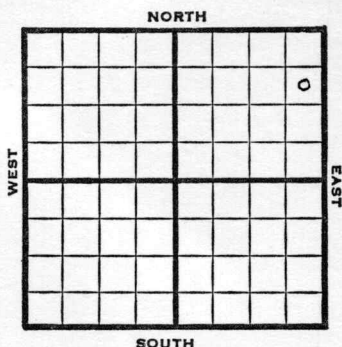

1948

Elev. 1432'

REPORT

5/19 Machine
5/26 Drlg. 365'
6/1 Drlg. 1315'
6/9 10" @ 1623'
Drlg. 2175'
6/16 2620 Run 8"
6/23 8" @ 2645'
Drlg 3005'
6/30 Miss 3007'
TD 3018'

ABANDONED

Map No. _____ Sec. 18 Twp. 26 R. 2E

Well No. 1 Schramm

J. P. Gatty Company

FIRST REPORT Contractor

SE NE NE


SECTION PLAT

990 Ft. from N. Line

_____ Ft. from S. Line

330 Ft. from E. Line

_____ Ft. from W. Line

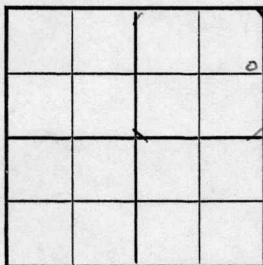

Sedgwick County

Location _____

Rig up _____

Drilling and Remarks:

Machine

RECORD

Cased _____ in., _____ ft.

Sand _____

Gas _____

Oil _____

Total Depth _____

PRODUCTION

1st 24 hrs. Nat. _____

1st 24 hrs. after shot _____

Gas _____ Cu. Ft.

Dry Hole _____

Abandoned _____

Date

MAY 19 1948 19 S. J. LEWIS Scout

Map No. 13 Sec. 18 Twp. 26 R. 2E

Well No. 1 Schramm

J. P. Gatty Company

ABANDONED Contractor

SE NE NE


E11432
SECTION PLAT

990 Ft. from N. Line

 Ft. from S. Line

330 Ft. from E. Line

 Ft. from W. Line

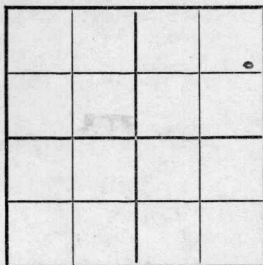

Sedgwick County

Location

Rig up

Drilling and Remarks:

Miss 300?

RECORD

Cased in., ft.

Sand

Gas

Oil

Total Depth 3018

PRODUCTION

1st 24 hrs. Nat.

1st 24 hrs. after shot

Gas Cu. Ft.

Dry Hole

Abandoned

Date

JUN 30 1948

19

S. J. LEWIS

Scout