

Sedgwick

Form 51-5M-2-29-34703


Map No. **KANSAS** Sec. *15* Twp. *26* R. *2E*

Well No. *1- Fischer* Farm

Shell Oil Corp. Company

NORTH

(Fischer)

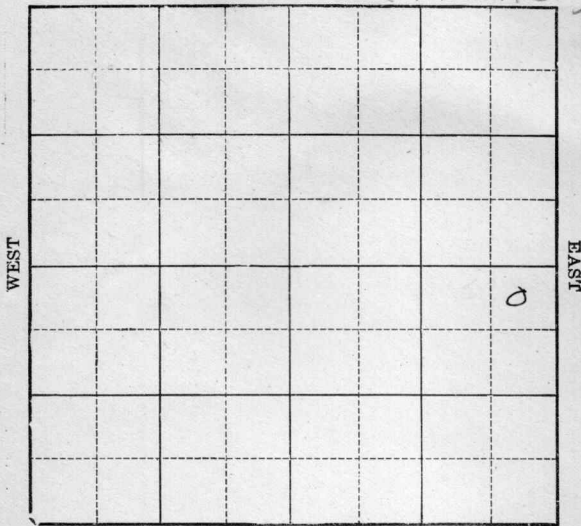

SOUTH

O. W. D. D

Location _____
Drilling Remarks _____

Rig Up _____
Drilling Remarks _____

RECORD


Cased _____ in. _____ ft.
Sand _____
Gas _____
Oil _____
Total Depth _____

PRODUCTION

1st 24 hrs. Nat. _____
1st 24 hrs. after shot _____
Gas _____ cu. ft. _____
Dry Hole _____
Abandoned _____

Stedwick
 Map No. KANSAS Sec. 15 Twp. 26 R. 2^E
 Well No. 1- Tucker Farm
Shell Pet Corp. Company

330 Ft. from N. Line
 _____ Ft. from S. Line
330 Ft. from E. Line
 _____ Ft. from W. Line

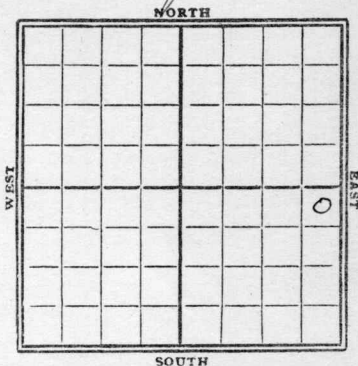

1929

Date _____ REPORT O. W. D. D

4/24 Location
 5/1 Rig
 5/8 116 ft. sur. pipe
 5/15 1825'
 5/22 " 2745
 5/29 " 3130
 6/7 Jop Pay 3199 T.D. 3202
 hole full oil stops over
 6/12 Simpson 3199-3203
 T.D. 3203'
 swab 784 bbl oil
 Pump.

1935
 11/27 T Wilcox 3242
 No 3314-18
 3333-34 1200' oil
 T.D. 3339 SW
 PB 3335
 12/6 112 oil & 4 water CO.
 15 oil & 5 water 6 hrs
 taking pot

(OVER)

12/11 TD 3339
PB 3335
Pot 175 Oil

COMPLETED

Map No. *13* **KANSAS** Sec. *15* Twp. *26* R. *24*

Well No. *1 Ficker*

Shell Oil Corp. Company

Contractor

SECTION PLAT

330 Ft. from N. Line

Ft. from S. Line

330 Ft. from E. Line

Ft. from W. Line

| | | | |
|--|--|--|---|
| | | | |
| | | | |
| | | | 0 |
| | | | |

FIRST REPORTS

Location *✓*

Rig up

Drilling and Remarks:

RECORD

Cased.....in.,ft.

Sand.....

Gas.....

Oil.....

Total Depth.....

PRODUCTION

1st 24 hrs. Nat.....

1st 24 hrs. after shot.....

Gas.....Cu. Ft.

Dry Hole.....

Abandoned.....

Date

APR 24 1920

192

S. J. LEWIS

Scout

Map No. KANSAS Sec. 15 Twp. 26 R. 25

Well No. 1 Fisher

Shell Pet. Corp. Company

Contractor

SECTION PLAT

330 Ft. from N. Line

..... Ft. from S. Line

330 Ft. from E. Line

..... Ft. from W. Line

COMPLETED

| | | | |
|--|--|--|---|
| | | | |
| | | | |
| | | | 0 |
| | | | |

Location.....

Rig up.....

Drilling and Remarks:

Sunjon 3199 & 3203

Swath 784 & 785

RECORD

Cased..... in., ft.

Sand.....

Gas.....

Oil.....

Total Depth 3203

PRODUCTION

1st 24 hrs. Nat.....

1st 24 hrs. after shot.....

Gas..... Cu. Ft.

Dry Hole.....

Abandoned.....

Date

JUN 12 1929

192.....

S. J. LEWIS

Scout

KANSAS

Form 26-1M Bks. -9-28

Map No. 13 Sec. 15 Twp. 26 R. 2E

Well No. Fisher

Shell petroleum Company

Contractor

FIRST REPORTS

SECTION PLAT

| | | | |
|--|--|--|---|
| | | | |
| | | | |
| | | | 0 |
| | | | |

330 Ft. from N. Line

Ft. from S. Line

330 Ft. from E. Line

Ft. from W. Line

ewad

Location

Rig up

Drilling and Remarks:

OTO 3203
 T. Wilcox 3242
 S.O. 3314-18.
 3333-34ft 1200 oil
 T. 3339 SW.
 P.B. 3335
 Swab 112 oil 4 water

C.O.

Date

11-27-35 192

RECORD

Cased in., ft.

Sand

Gas

Oil

Total Depth

PRODUCTION

1st 24 hrs. Nat.

1st 24 hrs. after shot

Gas Cu. Ft.

Dry Hole

Abandoned

ORVAL MANNSCHECK

Scout

Map No. 13 Sec. 15 Twp. 26 R. 2E

Well No. 1-K.F. Fisher

Shell Company

Contractor

SECTION PLAT

330 Ft. from N. Line

..... Ft. from S. Line

330 Ft. from E. Line

..... Ft. from W. Line

| | | | |
|--|--|--|---|
| | | | |
| | | | |
| | | | 0 |
| | | | |
| | | | |

COMPLETED

Location.....

Rig up.....

Drilling and Remarks:

P.B. 3335

Pat 175 oil

RECORD

Cased..... in., ft.

Sand.....

Gas.....

Oil.....

Total Depth 3339

PRODUCTION

1st 24 hrs. Nat.....

1st 24 hrs. after shot.....

Gas..... Cu. Ft.

Dry Hole.....

Abandoned.....

Date

12-11-35 192..... Scout

ORVAL MANNSCHRECK