KANSAS


B ulter

FORM 51 5M 10-41 PETROL

Section 34 Township 27 Range 6-E

Well No. #2 Vandenberg

Company J. J. Lynn

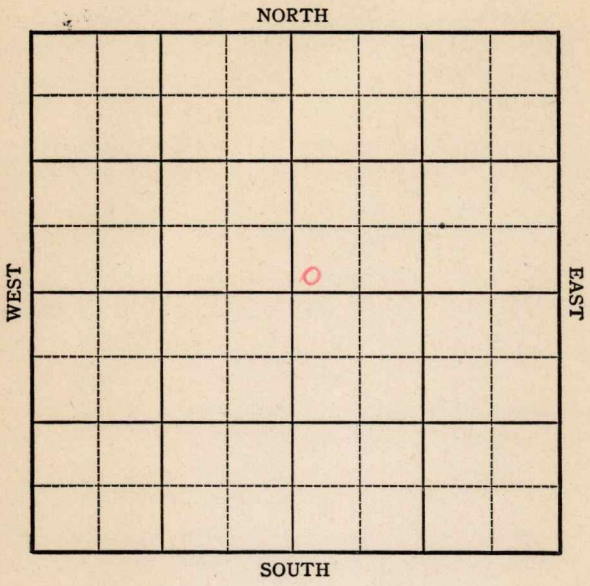

Form 252-A
5M 5-42 Petrol

KANSAS

Butler

Sec. 34 Twp. 27 R. 6-E

Well No. #2 Bandenberg Farm

J.J.Lynn Company

Miscellaneous


____ Ft. from N. Line

330 Ft. from S. Line

____ Ft. from E. Line

330 Ft. from W. Line

SW NE

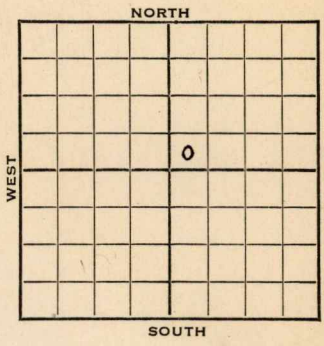

Eg 1412

1942	REPORT
12/16	Location
12/22	"
12/29	"
1943 1/6	"
1/13	"
1/20	Derrick
1/27	"
2/3	"
2/10	"
2/17	Spud
2/24	10" Casing set 115 Drlg. 635'
3/3	Lans 1688 KC 2097 Miss 2735 Drlg. 2903'
3/10	B. Miss 3003 Simp , olo 3083-87 TD Run 7".
3/17	7" Casing set 3083' WOC.

OVER

1943

3/24 T.D. 3129 water
PB 2125'
10 shots 2118-23 CO.

3/31 Plug 2108 ripped csg. with acidize.

4/7 " " " "

4/14 3500 acid SSO

4/21 Simp. sd. 3116
7" @ 3083'
T.D. 3129'
Water

ABANDONED

Form 26 200 Bks 5-42 Petrol

Butler

KANSAS

Map No. // Sec. 34 Twp. 27 R. 6E

Well No. 2 Bandenberg

J. J. Lynn Company

FIRST REPORT Contractor

SW NE


Ft. from N. Line

330 Ft. from S. Line

Ft. from E. Line

330 Ft. from W. Line

SECTION PLAT

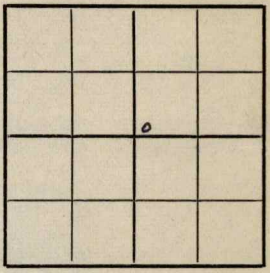

MISCELLANEOUS

Location XXX

Rig up

Drilling and Remarks:

RECORD

Cased in., ft.

Sand

Gas

Oil

Total Depth

PRODUCTION

1st 24 hrs. Nat.

1st 24 hrs. after shot

Gas Cu. Ft.

Dry Hole

Abandoned

Date

DEC 16 1942 19 S. J. LEWIS Scout

Form 26 200 Bks 5-42 Petrol

KANSAS

Butler

Map No. 1 1 Sec. 34 Twp. 27 R. 6E


Well No. 2 Vandenberg

J. J. Lynn Company

ABANDONED Contractor

SW NE

SECTION PLAT

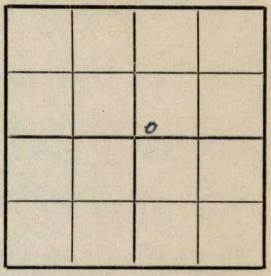

Ft. from N. Line

330 Ft. from S. Line

Ft. from E. Line

330 Ft. from W. Line

MISCELLANEOUS

Location

Rig up

Drilling and Remarks:

Simp Sd 3116

7" @ 3083

Water.

RECORD

Cased in., ft.

Sand

Gas

Oil

Total Depth 3129

PRODUCTION

1st 24 hrs. Nat.

1st 24 hrs. after shot

Gas Cu. Ft.

Dry Hole

Abandoned

Date

APR 2 1 1943 19

S. J. LEWIS Scout