


Map No. KANSAS Sec. 15 Twp. 26 R. 2 E
Well No. 2 - Fischer Farm _____
Shell Pet Corp. Company _____
NORTH (Fischer)

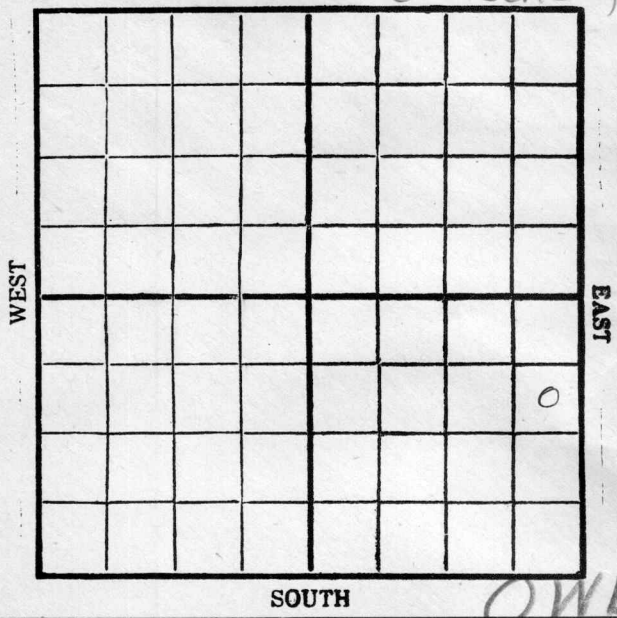

Location _____
Drilling Remarks _____

Rig Up _____
Drilling Remarks _____

RECORD

Cased _____ in. _____ ft.
Sand _____
Gas _____
Oil _____
Total Depth _____

PRODUCTION

1st 24 hrs. Nat. _____
1st 24 hrs. after shot _____
Gas _____ cu. ft. _____
Dry Hole _____
Abandoned _____


Map No. KANSAS Sec. 15 Twp. 26 R. 2E
Well No. 2- Fitcher Farm
Shell Pet Corp Company

950 Ft. from N. Line

_____ Ft. from S. Line

330 Ft. from E. Line

_____ Ft. from W. Line

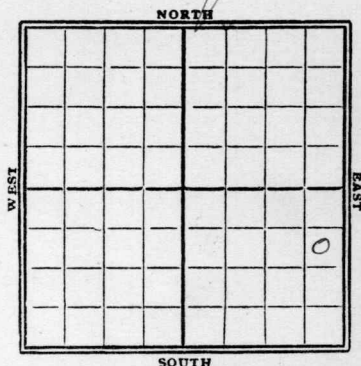

1929

Date REPORT O. W. D. D

7/17 Reg

7/24 15 1/2" - 86'

7/31 Hrlg 1725'

8/7 " 2600'

8/14 " 2850

8/21 TD 2885- R.H.S.T.

8/28 Chat 2928-29

swab 225 bbl oil

196 bbls water

9/5 sand 2928-31'

T.D. 2931'

swab 1282 bbl oil

450 " water

Comp.

1929 OWDID

9/11 Hrlg 3085'

9/18 " 3115'

9/25 Simpson 3198-3200

T.D. 3200'

swab 422 bbl oil

trace of water

Comp. - OVER -

1935

1/16 Wilcox 3362

T.D. 3313 U.R. 5"

1/24 — 1/31 —

2/7 Sand 3315 S.O. 3321-24
400' oil Swab 30 oil 24 hrs.

2/14 Shot 5 qts C.O.

2/20 Sand 3315
Oil 3321-34
43 Bbls.

COMPLETED

O.W.D.D

1937

2/24 Old T.D. 3334'.

Sil. 3352'.

T. D. 3354'.

5 qts. 3341-46'.

P.B. 3351'.

Potential 102.

FIRST REPORTS

and

COMPLETED

Map No. 13 KANSAS Sec. 15 Twp. 26 R. 2E

Well No. 2 Fisher

Shell Pet. Corp. Company

Contractor

SECTION PLAT

950 Ft. from N. Line

_____ Ft. from S. Line

830 Ft. from E. Line

_____ Ft. from W. Line

			0

FIRST REPORTS

Location_____

Rig up_____

Drilling and Remarks:

Rig

RECORD

Cased_____in., _____ft.

Sand_____

Gas_____

Oil_____

Total Depth_____

PRODUCTION

1st 24 hrs. Nat._____

1st 24 hrs. after shot_____

Gas_____Cu. Ft.

Dry Hole_____

Abandoned_____

Date

JUL 17 1929

S. J. LEWIS Scout

Map No. 13 KANSAS Sec. 15 Twp. 26 R. 25Well No. 2 FisherShell Pet. Corp. Company

Contractor


SECTION PLAT

950 Ft. from N. Line

Ft. from S. Line

320 Ft. from E. Line

Ft. from W. Line

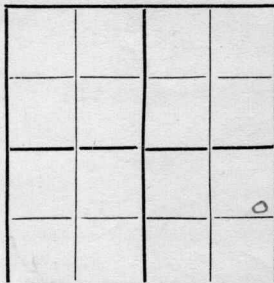

COMPLETED

Location

Rig up

Drilling and Remarks:


RECORD

Cased _____ in., _____ ft.

Sand 2928-31

Gas _____

Oil _____

Total Depth 2931

PRODUCTION

1st 24 hrs. Nat. _____

1st 24 hrs. after shot _____

Gas _____ Cu. Ft.

Dry Hole _____

Abandoned _____

Date

SEP 4 1929192S. J. LEWISScout

Seeligweck
 Map No. KANSAS Sec. 15 Twp. 26 R. 2E
 Well No. 2 Fisher
Shell O. & G. Corp. Company

Contractor

SECTION PLAT

			0

950 Ft. from N. Line
 _____ Ft. from S. Line
330 Ft. from E. Line
 _____ Ft. from W. Line

OW□□

Location _____
 Rig up _____
 Drilling and Remarks:

RECORD

Cased _____ in., _____ ft.
 Sand _____
 Gas _____
 Oil _____
 Total Depth _____

PRODUCTION

1st 24 hrs. Nat. _____
 1st 24 hrs. after shot _____
 Gas _____ Cu. Ft.
 Dry Hole _____
 Abandoned _____

Del 8080

Date

SEP 11 1929

192

S. J. LEWIS

Scout

Bedgwick
 Map No. KANSAS Sec. 15 Twp. 26 R. 2E

Well No. 2 Fisher

Shell Oil Corp. Company

Contractor

SECTION PLAT

950 Ft. from N. Line

..... Ft. from S. Line

330 Ft. from E. Line

..... Ft. from W. Line

COMPLETED

			0

Location.....

Rig up.....

Drilling and Remarks:

Simpson
3198-3200

Swab 42' 8 1/2'
Trace water

RECORD

Cased.....in.,ft.

Sand.....

Gas.....

Oil.....

Total Depth 3200

PRODUCTION

1st 24 hrs. Nat.....

1st 24 hrs. after shot.....

Gas.....Cu. Ft.

Dry Hole.....

Abandoned.....

Date

SEP 25 1929

192.....

S. J. LEWIS

Scout

Map No. 13 Sec. 15 Twp. 26 R. 2EWell No. 2-FisherShell pet. Company

Contractor

FIRST REPORTS

SECTION PLAT

			0

950 Ft. from N. Line

Ft. from S. Line

330 Ft. from E. Line

Ft. from W. Line

CWNN

Location

Rig up

Drilling and Remarks:

OTU 3202
Wilcoy 3262
TN 3313
4R5"

RECORD

Cased.....in.,ft.

Sand.....

Gas.....

Oil.....

Total Depth.....

PRODUCTION

1st 24 hrs. Nat.....

1st 24 hrs. after shot.....

Gas.....Cu. Ft.

Dry Hole.....

Abandoned.....

Date

1-16-35 192

ORVAL MANNSCHRECK

Scout

Map No. 13 Sec. 15 Twp. 26 R. 2EWell No. 2-Fishershell pit. Company

Contractor

COMPLETED

SECTION PLAT

			0

950 Ft. from N. Line

Ft. from S. Line

330 Ft. from E. Line

Ft. from W. Line

Location

Rig up

Drilling and Remarks:

RECORD

Cased in. ft.

Sand 3315

Gas

Oil 3321-34

Total Depth

PRODUCTION

1st 24 hrs. Nat.

1st 24 hrs. after shot

Gas Cu. Ft.

Dry Hole

Abandoned

Date

ORVAL MANNSCHRECK

2-20-35 192

Scout

Map No. 13 Sec. 15 Twp. 26 R. 2EWell No. 2 FisherShell Company

Contractor

SECTION PLAT

950 Ft. from N. Line

_____ Ft. from S. Line

380 Ft. from E. Line

_____ Ft. from W. Line

FIRST REPORT
COMPLETEDOWITT

Location _____

Rig up _____

Drilling and Remarks:

Old TD 3334Sil 335259 to 3341-46P.B. 3351Potential 102.

RECORD

Cased _____ in., _____ ft.

Sand _____

Gas _____

Oil _____

Total Depth 3354

PRODUCTION

1st 24 hrs. Nat. _____

1st 24 hrs. after shot _____

Gas _____ Cu. Ft.

Dry Hole _____

Abandoned _____

Date

FEB 24 1937

19

S. J. LEWIS

Scout