


Map No. KANSAS Sec. 15 Twp. 26 R. 2<sup>E</sup>

Well No. 6-Shell Fischer Farm  
Shell Pet Corp Company

**NORTH** (Fischer)

WEST

EAST

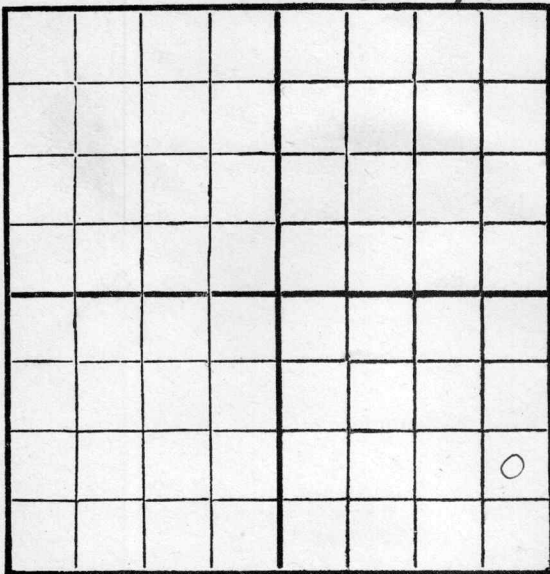

**SOUTH**

O. W. D. D

Location \_\_\_\_\_

Drilling Remarks

Rig Up \_\_\_\_\_

Drilling Remarks

**RECORD**

Cased \_\_\_\_\_ in. \_\_\_\_\_ ft.

Sand \_\_\_\_\_

Gas \_\_\_\_\_

Oil \_\_\_\_\_

Total Depth \_\_\_\_\_

**PRODUCTION**

1st 24 hrs. Nat. \_\_\_\_\_

1st 24 hrs. after shot \_\_\_\_\_

Gas \_\_\_\_\_ cu. ft. \_\_\_\_\_

Dry Hole \_\_\_\_\_

Abandoned \_\_\_\_\_

Map No. KANSAS Sec. 15 Twp. 26 R. 2<sup>E</sup>

Well No. 6 - Fisher Farm


Shell Pet Company

\_\_\_\_\_ Ft. from N. Line

940 Ft. from S. Line

330 Ft. from E. Line

1930 Ft. from W. Line

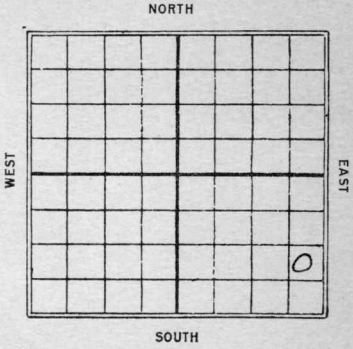

Date \_\_\_\_\_ REPORT **O.W.D.D**

1/15 Loc.

1/22 Rgn up

1/29 set 15 1/2" - 118'

2/5 Drly 1997

2/12 set 18" - 2191' Rust

2/19 Top Chat 2917 - 250'  
oil in hole.

2/26 swabbed 30 bbls oil  
1200 bbls water - Drly.  
3080.

3/5 5" 3208' Viola 3208-9 1/2'  
698' oil 20 hrs.

3/12 Sand 3208-09 1/2'  
T.D. 3209 1/2'  
swab 698 bbl oil  
Comp

1935 **O.W.D.D**

7/10 Rgn

7/18 3410 U.R. 6"

7/8 3320 fsg.

8/15 7" 3317 W.O.C.

(OVER)

8/22 3325 T7  
Swab 270 Hls 12 hrs  
T Viola 3208

8/29 Wilcox 3320  
T7 3340  
Swab 320 Hls 24 hrs.

9/4 Wilcox 3320  
T7 3340  
254 Hls.

COMPLETED

Map No. 130 **KANSAS** Sec. 15 Twp. 26 R. 2 E

Well No. 6 Fisher

Shell Pet. Corp. Company

Contractor

**SECTION PLAT**

			0

\_\_\_\_\_ Ft. from N. Line

990 Ft. from S. Line

330 Ft. from E. Line

\_\_\_\_\_ Ft. from W. Line

**FIRST REPORTS**

Location ✓

Rig up \_\_\_\_\_

Drilling and Remarks:

**RECORD**

Cased \_\_\_\_\_ in., \_\_\_\_\_ ft.

Sand \_\_\_\_\_

Gas \_\_\_\_\_

Oil \_\_\_\_\_

Total Depth \_\_\_\_\_

**PRODUCTION**

1st 24 hrs. Nat. \_\_\_\_\_

1st 24 hrs. after shot \_\_\_\_\_

Gas \_\_\_\_\_ Cu. Ft.

Dry Hole \_\_\_\_\_

Abandoned \_\_\_\_\_

Date

JAN 25 1930

19

S. J. LEWIS Scout

Map No. *13* **KANSAS** Sec. *15* Twp. *26* R. *25*

Well No. *6 Fisher*

*Shell P & Corp* Company

Contractor

**SECTION PLAT**

			0

.....Ft. from N. Line

*990* Ft. from S. Line

*230* Ft. from E. Line

.....Ft. from W. Line

**COMPLETED**

**RECORD**

Location.....

Cased..... in., ..... ft.

Rig up.....

Sand *32.08 - 09 1/2*

Drilling and Remarks:

Gas.....

Oil.....

Total Depth *3209 1/2*

*Swat 698886*

**PRODUCTION**

1st 24 hrs. Nat.....

1st 24 hrs. after shot.....

Gas..... Cu. Ft.

Dry Hole.....

Abandoned.....

Date

*MAR 12 1930*

*S. J. LEWIS* Scout

Map No. 13 Sec. 15 Twp. 26 R. 2E

Well No. 6-Fisher

Shell pet Company

Contractor

FIRST REPORTS

SECTION PLAT

..... Ft. from N. Line

990 Ft. from S. Line

330 Ft. from E. Line

..... Ft. from W. Line

			0

QWPN

Location.....

Rig up.....

Drilling and Remarks:

OTD 3209 1/2

Rig N

RECORD

Cased..... in., ..... ft.

Sand.....

Gas.....

Oil.....

Total Depth.....

PRODUCTION

1st 24 hrs. Nat.....

1st 24 hrs. after shot.....

Gas..... Cu. Ft.

Dry Hole.....

Abandoned.....

Date

7-10-35

192

ORVAL MANN-SHRECK

Scout

KANSAS

Map No. 13 Sec. 15 Twp. 26 R. 28

Well No. 6-Fisher

Shell Petroleum Company

Contractor

**COMPLETED**

SECTION PLAT

.....Ft. from N. Line

990 Ft. from S. Line

330 Ft. from E. Line

.....Ft. from W. Line

			0

Location.....

Rig up.....

Drilling and Remarks:

254 bbls

RECORD

Cased..... in., ..... ft.

Sand Wilcox 3320

Gas.....

Oil.....

Total Depth 3340

PRODUCTION

1st 24 hrs. Nat.....

1st 24 hrs. after shot.....

Gas..... Cu. Ft.

Dry Hole.....

Abandoned.....

Date

9-4-35 192.....

ORVAL MANNSCHECK

Scout