


Well No. 1 Lucas Farm

White Eagle et al Company

NORTH

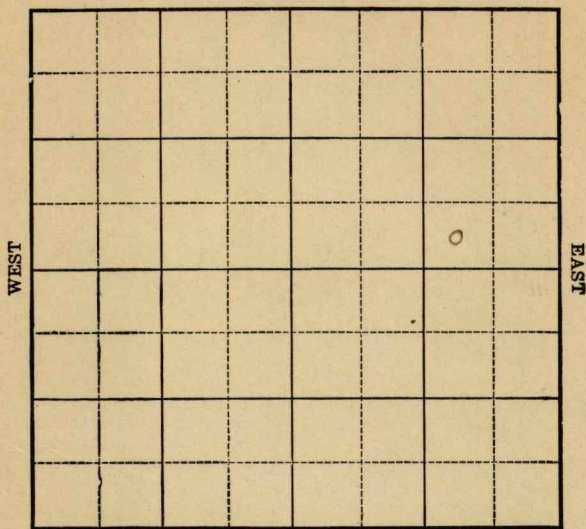

SOUTH

Rig Up_____

Drilling Remarks

PRODUCTION

1st 24 hrs. Nat. _____

1st 24 hrs. after shot_____

Gas _____ cu. ft.

Dry Hole _____


Abandoned -----

Map No. 1 Sec. 1 Twp. 27 R. 7Well No. 1 Lucas FarmWhite Eagle O & R. Company

Ft. from N. Line

330 Ft. from S. Line990 Ft. from E. Line

Ft. from W. Line

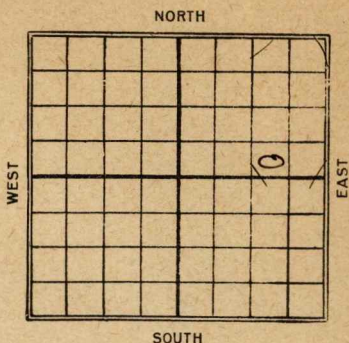1926

Date

REPORT

9/15 Location9/22 same9/29 same10/3 rig10/27 Spudding 120'11/11 Drilg 79011/17 " 105011/23 " 1520'12/8 " 200012/15 " 2250'12/22 " 250012/30 fishing 269019271/6 same1/13 —1/19 —1/26 5" - 27002/3 Drilg. 27352/10 " 28902/17 —2/24 " 29503/2 Top line 2735 - Wilcox

3140-3149 - HFW - D. & A.

Butler

10 KANSAS

Map No. _____ Sec. 1 Twp. 27 R. 7

Well No. 1 Lucas

White Eagle, OK, et al Company

Contractor

FIRST REPORTS

_____ Ft. from N. Line

220 _____ Ft. from S. Line

990 _____ Ft. from E. Line

_____ Ft. from W. Line

SECTION PLAT

Location ✓ _____

Rig up _____

Drilling and Remarks:

RECORD

Cased _____ in., _____ ft.

Sand _____

Gas _____

Oil _____

Total Depth _____

PRODUCTION

1st 24 hrs. Nat. _____

1st 24 hrs. after shot _____

Gas _____ Cu. Ft.

Dry Hole _____

Abandoned _____

Date

192

CHAS. L. SHERWOOD

Scout

SEP 15 1926

Butler

10 **KANSAS** Sec. 1 Twp. 27 R. 7Well No. 1 Lucas
White Eagle Oil & Gas Company

Contractor

COMPLETED**SECTION PLAT**

Ft. from N. Line

330 Ft. from S. Line

330 Ft. from E. Line

Ft. from W. Line

ABANDONED

Location

Rig up

Drilling and Remarks:

Tap line 2735'

Wilcox 3140-3149

A&W

D&H 3149'

RECORD

Cased _____ in., _____ ft.

Sand _____

Gas _____

Oil _____

Total Depth 3149'

PRODUCTION

1st 24 hrs. Nat. _____

1st 24 hrs. after shot _____

Gas _____ Cu. Ft.

Dry Hole ✓

Abandoned ✓

Date

MAR 2 1927 CHAS. L. SHERWOOD

192

Scout