


Map No. KANSAS Sec. 15 Twp. 26 R. 2^E
Well No. 3- Fischer Farm
Shell Pit Corp. Company

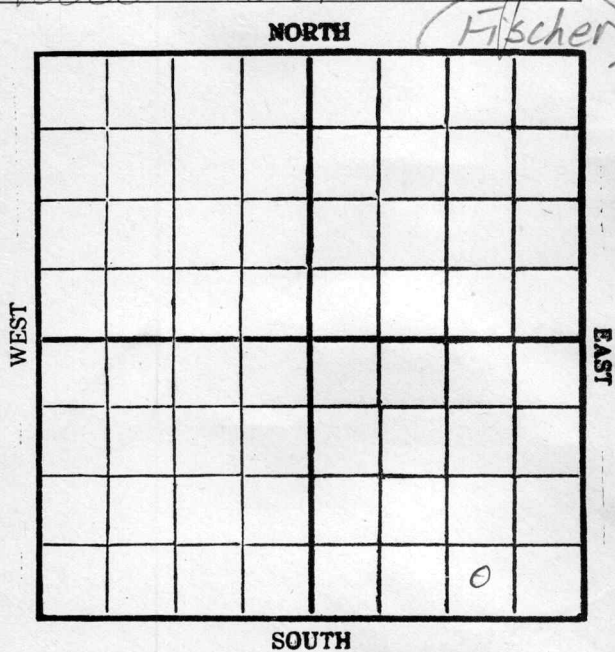

Location _____
Drilling Remarks _____

Rig Up _____
Drilling Remarks _____

RECORD

Cased _____ in. _____ ft.
Sand _____
Gas _____
Oil _____
Total Depth _____

PRODUCTION

1st 24 hrs. Nat. _____
1st 24 hrs. after shot _____
Gas _____ cu. ft. _____
Dry Hole _____
Abandoned _____


Map No. KANSAS Sec. 15 Twp. 26 R. 2^E
Well No. 3 - Fisher Farm
Shell Pet Corp Company

_____ Ft. from N. Line

330 Ft. from S. Line

990 Ft. from E. Line

_____ Ft. from W. Line

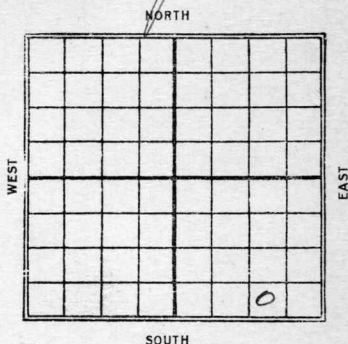

1929


Date REPORT

10/2	Bledy Rig
10/19	Rign up
10/16	for pipe 1535
10/23	Rem 8" - 2880'
10/30	
11/6	Drly 2943' 7" - 2940
11/13	HFW 2965-70
	T.D. 3130 - W.R. 7"
11/20	—
11/27	C. O.
12/4	ully 3175
12/11	3231
12/18	Top sand 3237'
	T.D. 3237
	swab 198 bbl oil
	Pump.

Map No. KANSAS Sec. 15 Twp. 26 R. 25Well No. S. FisherShell Pet. Corp. Company

Contractor

SECTION PLAT

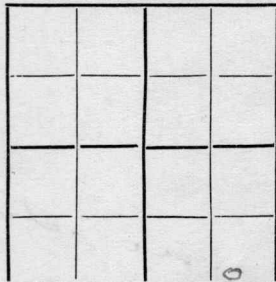

Ft. from N. Line

330 Ft. from S. Line990 Ft. from E. Line

Ft. from W. Line

FIRST REPORTS

Location

Rig up

Drilling and Remarks:

Building rig

RECORD

Cased.....in., ...ft.

Sand.....

Gas.....

Oil.....

Total Depth.....

PRODUCTION

1st 24 hrs. Nat.....

1st 24 hrs. after shot.....

Gas.....Cu. Ft.

Dry Hole.....

Abandoned.....

Date

OCT 2 1929 192 S. J. LEWIS Scout

Map No. KANSAS Sec. 15 Twp. 26 R. 25

Well No. 3 Fisher

Shell Oil Corp. Company

Contractor

SECTION PLAT

			0

_____ Ft. from N. Line

320 Ft. from S. Line

990 Ft. from E. Line

_____ Ft. from W. Line

COMPLETED

RECORD

Location _____

Cased _____ in., _____ ft.

Rig up _____

Sand _____

Drilling and Remarks:

Gas _____

Oil _____

Total Depth 3237

Top Sand 3237

PRODUCTION

Swab 1984/1985

1st 24 hrs. Nat. _____

1st 24 hrs. after shot _____

Gas _____ Cu. Ft.

Dry Hole _____

Abandoned _____

Date

DEC 18 1929

S. J. LEWIS Scout