


Map No. _____ Sec. 36 Twp. 27 R. 6
 Well No. 4 - Bigge Farm
J. H. Liggett Company

NORTH

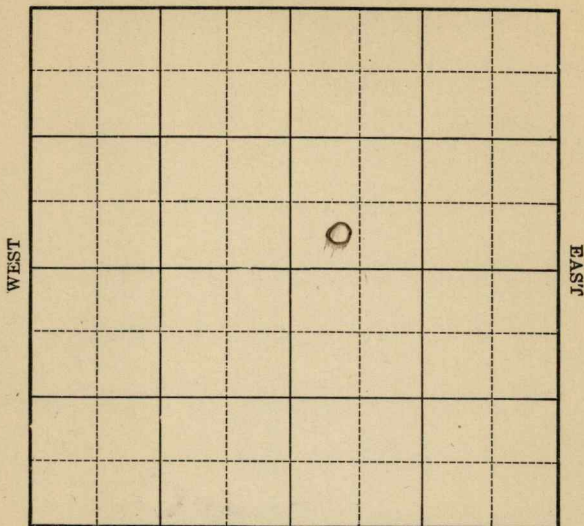

SOUTH

Location _____

Drilling Remarks _____

Rig Up _____

Drilling Remarks _____

RECORD

Cased _____ in. _____ ft.

Sand _____

Gas _____

Oil _____

Total Depth _____

PRODUCTION

1st 24 hrs. Nat. _____

1st 24 hrs. after shot _____

Gas _____ cu. ft.

Dry Hole _____

Abandoned _____

Map No. _____ Sec. 36 Twp. 27 R. 6Well No. 4 - Figger Farm
J. H. Liggett Company

NORTH

_____ Ft. from N. Line

330 Ft. from S. Line

_____ Ft. from E. Line

540 Ft. from W. Line1927

WEST

EAST

SOUTH

Date

REPORT

10/6	Spudding
10/12	
10/19	Drlg 710-
10/27	" 1100'
11/2	" 1810'
11/9	Runig 8"-2320
11/16	Drlg 2430
11/23	Sand 2735-2752
	T.D. 2828 - L. & G.
	Top line 2802

11 **KANSAS** Sec. 36 Twp. 27 R. 6

Well No. 4 J. D. Liggert Company

Contractor

FIRST REPORTS

Ft. from N. Line

330

Ft. from S. Line

Ft. from E. Line

540

Ft. from W. Line

SECTION PLAT

Location

Rig up

Drilling and Remarks:

Spog

RECORD

Cased in., ft.

Sand

Gas

Oil

Total Depth

PRODUCTION

1st 24 hrs. Nat.

1st 24 hrs. after shot

Gas Cu. Ft.

Dry Hole

Abandoned

Date

OCT 6 - 1927

192

CHAS. L. SHERWOOD

Scout

Butler

 11 **KANSAS** 36 27 6
 Map No. _____ Sec. _____ Twp. _____ R. _____

 Well No. 4 *Figure*
J. R. Liggett _____ Company

_____ Contractor

COMPLETED**SECTION PLAT**

_____ Ft. from N. Line

330 _____ Ft. from S. Line

_____ Ft. from E. Line

540 _____ Ft. from W. Line

ABANDONED

Location _____

Rig up _____

Drilling and Remarks:

*Sand 2735-2752**Top Lime 2802'**194 2828***RECORD**

Cased _____ in., _____ ft.

Sand _____

Gas _____

Oil _____

Total Depth *2828***PRODUCTION**

1st 24 hrs. Nat. _____

1st 24 hrs. after shot _____

Gas _____ Cu. Ft.

Dry Hole *✓*Abandoned *✓*

Date

NOV 23 1927

CHAS. L. SHERWOOD

192

Scout