


Map No. KANSAS Sec. 15 Twp. 26 R. 2^E

Well No. 7-f Fischer Farm

Shelley Pet Company

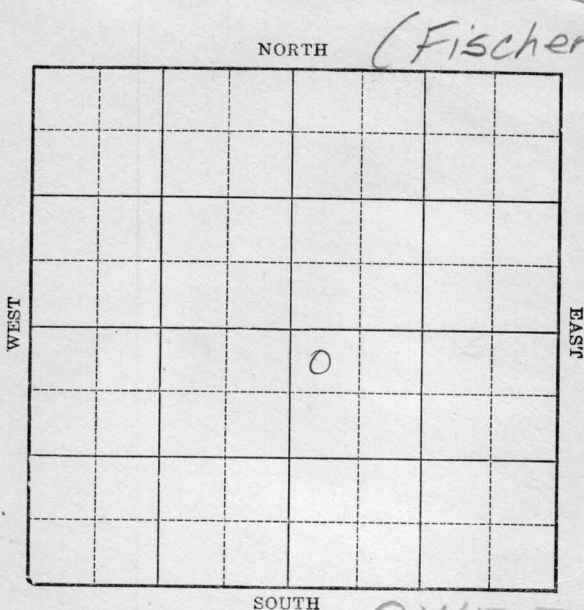

Location _____

Drilling Remarks _____

Rig Up _____

Drilling Remarks _____

RECORD

Cased _____ in. _____ ft.

Sand _____

Gas _____

Oil _____

Total Depth _____

PRODUCTION

1st 24 hrs. Nat. _____

1st 24 hrs. after shot _____

Gas _____ cu. ft.

Dry Hole _____


Abandoned _____

Map No. KANSAS Sec. 15 Twp. 26 R. 2^E

Well No. T. J. Fisher Farm

Shell Bit Company

NORTH

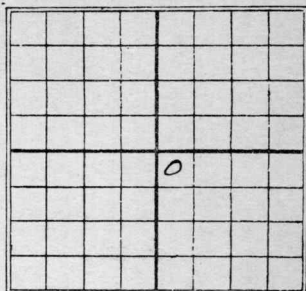

SOUTH

330 Ft. from N. Line

_____ Ft. from S. Line

_____ Ft. from E. Line

330 Ft. from W. Line

1930

Date

REPORT

4/23	Drly 810'
4/30	" 2527'
5/7	8" 2867 T.D. 2875'
	rust
5/14	Chat 2908-10
	2500' oil in hole.
5/21	T.D. 2916 — 300
	bbls water
	1200 bbls water
5/28	Chat 2908-16'
	TD 2916
	Swab 579 bbl oil
	and 1600 " water
	Comp.
1931	OWDID
5/20	Old T.D. 2916 Run up
5/27	UIR 6"- 3080'
6/3	UIR 6"- 3185'
6/10	Cem 6"- 3185'
6/17	Top Viola 3194
	TD. 3200
	Made 215 bbl 6 hr

6/24- Viola 3194-3200
T.D. 3200'
Made 215 bbl 6 hr
Comp.

Map No. 13 **KANSAS** Sec. 15 Twp. 26 R. 2E

Well No. 7 Fisher

Shell P. & O. Corp. Company

Contractor

SECTION PLAT

330 Ft. from N. Line

..... Ft. from S. Line

..... Ft. from E. Line

330 Ft. from W. Line

		0	

FIRST REPORTS

Location.....

Rig up.....

Drilling and Remarks:

Log 510

RECORD

Cased..... in., ... ft.

Sand.....

Gas.....

Oil.....

Total Depth.....

PRODUCTION

1st 24 hrs. Nat.....

1st 24 hrs. after shot.....

Gas..... Cu. Ft.

Dry Hole.....

Abandoned.....

Date

192.....

S. J. LEWIS

Scout

Map No. KANSAS Sec. 15 Twp. 26 R. 2E

Well No. 7 Fisher

Shell Oil Corp. Company

Contractor

SECTION PLAT

230 Ft. from N. Line

..... Ft. from S. Line

..... Ft. from E. Line

230 Ft. from W. Line

COMPLETED

		0.	

Location.....

Rig up.....

Drilling and Remarks:

Chat 2908-16

swath 579 x 1/2
oil x 1600 x 1/2
water.

RECORD

Cased.....in., ...ft.

Sand.....

Gas.....

Oil.....

Total Depth 2916

PRODUCTION

1st 24 hrs. Nat.....

1st 24 hrs. after shot.....

Gas.....Cu. Ft.

Dry Hole.....

Abandoned.....

Date

MAY 28 1930

192.....

S. J. LEWIS

Scout

18 KANSAS Sec. 15 Twp. 26 R. 2 E

Well No. 7 Fisher
Sheep pet Co Company

Contractor

FIRST REPORTS

330 Ft. from N. Line

Ft. from S. Line

Ft. from E. Line

330 Ft. from W. Line

SECTION PLAT

		0	

"Old well deeper"

Location

Rig up JD 2916

Drilling and Remarks:

Rgn up

RECORD

Cased in., ft.

Sand

Gas

Oil

Total Depth

PRODUCTION

1st 24 hrs. Nat.

1st 24 hrs. after shot

Gas Cu. Ft.

Dry Hole

Abandoned

Date

MAY 20 1931

192

CHAS. L. SHERWOOD

Scout

Map No. KANSAS Sec. 15 Twp. 26 R. 2 E
 Well No. 7 Fisher

Sheep Pet Co Company
 Contractor

COMPLETE

SECTION PLAT

		0	

230 Ft. from N. Line

..... Ft. from S. Line

..... Ft. from E. Line

230 Ft. from W. Line

Location.....

Rig up.....

Drilling and Remarks:

215 lbs 6 hours

RECORD

Cased..... in., ... ft.

Sand Udala 3194-3200

Gas.....

Oil.....

Total Depth 3200

PRODUCTION

1st 24 hrs. Nat.....

1st 24 hrs. after shot.....

Gas..... Cu. Ft.

Dry Hole.....

Abandoned.....

Date
JUN 2 4 1931

CHAS. L. SHERWOOD

192..... Scout