


Section 33 Township 18 Range 10 W

Well No. # 2 Buehler (B)

Company Skelly

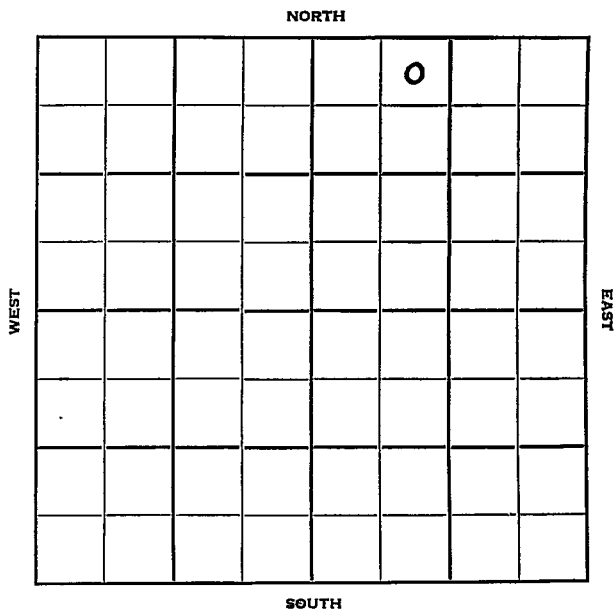

Rice KANSAS



Sec. 33 Twp. 18 R. 10 W

Well No. # 2 Buehler (B) Farm

Skelly Company

Charlie Hulme Contractor


330 Ft. from N. Line

Ft. from S. Line

Ft. from E. Line

990 Ft. from W. Line

NE NW NE

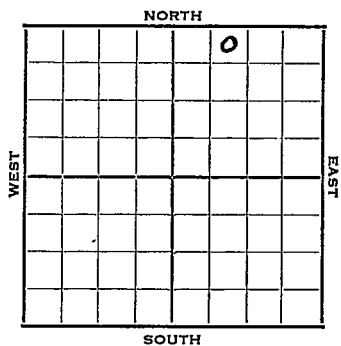

1952 Elev. 1740' REPORT

3/26 Moving In
 4/1 Drlg. 350'
 4/9 8" @ 440
 Drlg. 2531'
 4/23 Heeb. 2718 Tor 2737
 Douglas 2750 Br Li 2834
 Lans. 2856
 Coring 3101-21 RTD 20' SSO
 5" @ 3102'
 4/30 NR
 5/7 DP DD 3122' TD Hyd CO
 5/14 NR
 5/21 "
 5/28 "
 6/11 "
 6/18 Spud 3-30-52 Oil Well TD 3122
 8" @ 440 Heeb. 2718 Tor. 2737
 Doug 2750 Br lime 2834 Lans. 2856
 5" @3102 TD 3122 Hydro
 Comp. 51 bopd

COMPLETED

