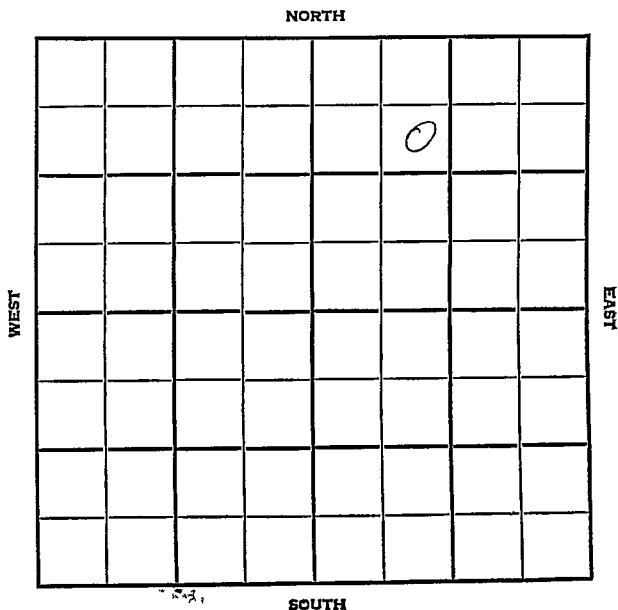


Section 33 Township 18 Range 10WWell No. #4 Buehler "B"Company Skelly Oil

Rice.

KANSAS

SEC.	TWP.	R.
33	18	10W

WELL NO.

#4 Buehler "B"

FARM

COMPANY

Skelly Oil

CONTRACTOR

Wentworth

Phase-Silica


_____ FT. FROM N. LINE

_____ FT. FROM S. LINE

_____ FT. FROM E. LINE

_____ FT. FROM W. LINE

SE NW NE

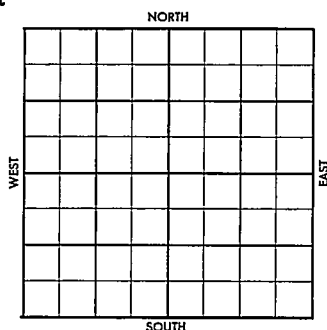

1956	ELEVATION	REPORT
	1737	

5-29

Comm. 5-24-56
8" @ 450 w/250

6-27

Anh. 439'
 DST2936-85 (60) gas (4) rec 300' HG &
 OCM / 240' O&GCWM BHP 380
 DST 2985-3116 (60) gas (4) est! 125
 MCF rec 50' DM BHP 1025; ce 3132
 5½ @ 3117/150 co 3151
 LWL tst 1 GO / 1 GWPH 4 hrs Viso-frac.
 § 61 BO / 12 BW 12 hrs.
 P 76 BO / 11 BW 24 hrs.
 H. 2721; Tr. 2743; Dg. Sd. 2753;
 BL. 2829; L. 2858; Qtsite 3115
 TD. 3151

COMPLETED

Date Comm.	5-24-56	Sec.
811 @	450/250	

~~SECRET~~

County	Rice	Elev.	1737	Co.
Sec.	33	Twp.	18	Rge.
Company	Skelly Oil			
Farm Name	Buehl r "B"	No.	1	

TOPS	DEPTH	LOG	DATUM	Loc. in Sec.
Anh.	139			SE NW NE
Tp.				
H.	2721			
Tr.	2743			
Dg.	2753			
Bl.	2839			
L.	2858			
K.C.				Geol.
B.K.C.				Contr.
Ce.				Wentworth
C.				
M.				Pool
M.				Chase-Silica
K.				
Mz.				
Mo.				
V.				
S.				
S.				
A.				
R.				
Pe.	27510 3115			COMPLETE
G.				
TD.	3151			

Date Comm.	5-24-56	JUN 27 '56
8" @ 450/250	JUN 13 '56	DST 2936-85
(60) 92x(4)	rec 300' H6+CLM + 240'	
O+GCLWM	BHP 380	
PE DST 2985-3116	(60) 92x(4)	
est 125 MCF	rec 50' DM BHP	
1625	C @ 3132	JUN 13 '56
5 1/2 @ 3117/150	C @ 3151	LWL
fst 1 G0 + 1 Gwph	4 hrs V150 -	
Frac 8.61 B0 + 12 BW	12 hrs	

FORM 513-1 SUNRAY

33-18-10 SE NW NE

JUN 27 '56 P. 76 B0 + 11 B0W

24 hrs