




**O.W.W.O.**

*Sedgwick*

Map No. **KANSAS** Sec. 15 Twp. 26 R. 2 E

Well No. 9 Fischer Farm \_\_\_\_\_  
Shell Pet. Company \_\_\_\_\_

990 Ft. from N. Line  
\_\_\_\_ Ft. from S. Line  
\_\_\_\_ Ft. from E. Line  
1344 Ft. from W. Line  
C S/2 N/2 SE

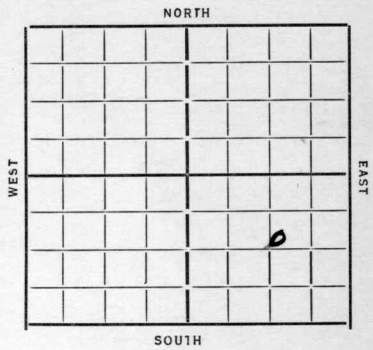

Date	Elev. 1413'	REPORT
10/10	Dlg 1625	15" 81.
10/18	" 2910	
10/25	Chst 2911	88 oil + 37 W 2921
	Dlg 3027	
11/1	B. Line 3118	7" 3170
11/8	Viola 3199	T 17 3201 450 Bbls oil 220 W 24 hrs.
11/15	1000 acid	450 oil + 225 water
11/21	Viola 3199	T 17 3201
	1000 acid	378 oil 1250 water

**COMPLETED**

**O.W.W.O.**

1955  
4/27

Oil Well - TD 3361'  
KC 2475', Miss 2904', Viola 3199',  
Simp. 3260', Arb. 3336'  
TD 3361'  
4" @ 3304'  
PB 2975', 26/2902-15, S/4 bo 34 bw  
5 hrs.  
Comp. 13 bopd 395 bw

**FIRST REPORT**

**COMPLETED**

Map No. 13 Sec. 15 Twp. 26 R. 2 E

Well No. 9 - Fischer

Shell pet Company \_\_\_\_\_ Contractor \_\_\_\_\_

**FIRST REPORTS SECTION PLAT**

990 Ft. from N. Line

\_\_\_\_\_ Ft. from S. Line

\_\_\_\_\_ Ft. from E. Line

1344 Ft. from W. Line


Location \_\_\_\_\_

Rig up \_\_\_\_\_

Drilling and Remarks:

15" 81'

Reg 1625

**RECORD**

Cased \_\_\_\_\_ in., \_\_\_\_\_ ft.

Sand \_\_\_\_\_

Gas \_\_\_\_\_

Oil \_\_\_\_\_

Total Depth \_\_\_\_\_

**PRODUCTION**

1st 24 hrs. Nat. \_\_\_\_\_

1st 24 hrs. after shot \_\_\_\_\_

Gas \_\_\_\_\_ Cu. Ft.

Dry Hole \_\_\_\_\_

Abandoned \_\_\_\_\_

Date

10-10-37 19

ORVAL MANNSCHRECK

Scout

Map No. 13 Sec. 15 Twp. 26 R. 2E

Well No. 9-Fisher

shell pet Company

Contractor

COMPLETED

SECTION PLAT

990 Ft. from N. Line

..... Ft. from S. Line

..... Ft. from E. Line

1344 Ft. from W. Line

			0

Location.....

Rig up.....

Drilling and Remarks:

1000 acid

878 oil

1250 water

RECORD

Cased..... in., ..... ft.

Sand Viola 3199

Gas.....

Oil.....

Total Depth 3201

PRODUCTION

1st 24 hrs. Nat.....

1st 24 hrs. after shot.....

Gas..... Cu. Ft.

Dry Hole.....

Abandoned.....

Date

11-21-37 192.....

ORVAL MANNSCHRECK Scout

O.W.W.O.

County Sedgwick State Kansas

Sec. 15 (Blk. Twp.) 26 (Sur. Rge.) 2E Map No.

Operator Shell Oil

Well No. 9 Farm Fischer

Elev. 1413 Location C S  $\frac{1}{2}$  W  $\frac{1}{2}$  SE

FIRST REPORT			
COMPLETE			

990 Ft. From N Line SE

1344 Ft. From E Line Quarter

Ist. Report APR 27 1955

Completion APR 27 1955

Remarks O.W.W.O.

Spudding Date O.W.W.O.

Drlg. Data Oil well TD 3361

KC 2475 Miss. 2904 Viola 3199

Simp. 3260 Arb. 3336 TD 3361 4" @

3304 PB 2975 26/ 2902-15 S/ 4 bo

34 bw 5 hr. Comp. 13 bopd 395 bw

FABEN GILSTRAP