


Rice

KANSAS

SECTION 33 TOWNSHIP 18S RANGE 10W

WELL NO. #8 Buehler "B"

COMPANY Skelly

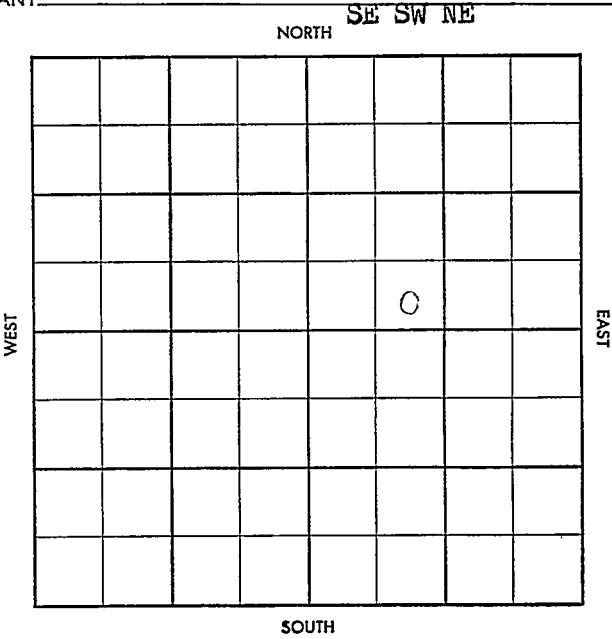

~~Tw...~~

~~...~~

County Rice Elev. 1736 DF  
 Sec. 33 Twp. 18 Rge. 10W  
 Company Skelly  
 Farm Name Buehler "B" No. 8


TOPS	DEPTH	LOG	DATUM
Anh.	<u>443</u>		
Tp.			
H.			
Tr.			
Dg.			
B.L.			
L.			
K.C.			
B.K.C.			
Ce.			
C.			
M.			
M.			
K.			
Mz.			
Mq.			
V.			
S.			
S.			
A.			
R.			
Pf.			
G.			
T.D.			

Loc. in Sec. \_\_\_\_\_  
SE SW NE  
 Geol. \_\_\_\_\_  
 Contr. \_\_\_\_\_  
Wentworth  
 Pool \_\_\_\_\_  
Calf Creek

**AUG 20 1958**  
**FIRST REPORT**

Date Comm. 8-13-58  
8 5/8" 1454/225 Drlg. 2485.

Co.  
 Use.  
 No.  
 Sec.  
 T.  
 R.

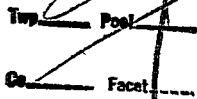

S-510.8

County Rice Elev. 1736 DF 1739 RB  
 Sec. 33 Twp. 18 Rge. 10W  
 Company Skelly  
 Farm Name Buehler "B" No. 8

TOPS	DEPTH	LOG	DATUM
Anh.	443		
Tp.	2475		
H.	2736		
Tr.	2758		
Dg.	2766		
B.L.	2850		
E.	2874		
K.C.			
B.K.C.			
Ce.			
C.	3125		
W. Gate	3137 1/2		
M.			
K.			
Mz.			
Mq.			
V.			
S.			
S.			
A.			
R.			
Pf.			
G.			
T.D.	3174		

Loc. in Sec. \_\_\_\_\_  
 Sh. St. ML \_\_\_\_\_  
 Geol. \_\_\_\_\_  
 Contr. \_\_\_\_\_  
 Wentworth \_\_\_\_\_  
 Pool \_\_\_\_\_  
 Calf Creek \_\_\_\_\_

**COMPLETE**  
 0  
 SEP 17 58

Date Comm. 8-13-58  
8 5/8" 454/225 Drlg. 2485. AUG 27 '58  
DST 2680-2710 1he 10' 8" WC Dry Mud.  
FP 15-25 SIP 505/65-20"  
DST 2947-71 1he gas 16" Res 116' 56" CM  
60' W Mud. FP 28-50 SIP 487/435-20  
Core 3125 1/2 - 35 6.4 N.S.  
" 3135 - 41 6.0 Blend bit  
" 3141 - 45 3.0 8ci " " Co Ahead  
SEP 3 '58 Core 3145 - 56 rec 7'  
Core 3156 - 71 rec 14'

Co.  
 Sec.  
 T.  
 R.

on 3170-74 in 4' log 5 1/2 318 1/2  
SEP 10 1958 Co 3174 B 3590 P 6NW  
3 1/2 hrs fine  
P 25 B O NW 24 hrs

φ

33-18-10 W

see in the

El. 1736  
TD 1438  
5/2 1404