

Section 34 Township 18 Range 10 WWell No. # 2 LaMunyonCompany Anderson-Prichard

NORTH

WEST

EAST

		0					

SOUTH

Sec. 34 Twp. 18 R. 10W

Well No. #2 LaMunyon Farm

Anderson-Prichard Company

B&B Contractor

Munyon


 Ft. from N. Line

330 Ft. from S. Line

990 Ft. from E. Line

 Ft. from W. Line

SW SE SW

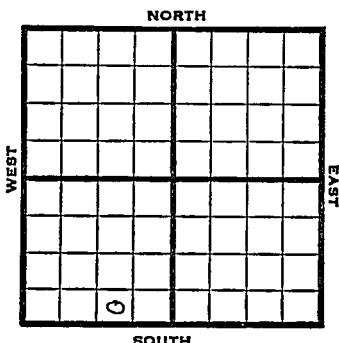

1952

Elev. 1734' REPORT

2/13 Cellar & pits

2/20 Drlg. 2650'

8" @ 261'

Anhy 445'

3/5 CO to 3303' SSO & M Fishing tubing

3/11 DD to 3304 20/3299-3304 3 gal oil
& w PH DD to 3307 20/3293-98 55 A
Test 9 BO 6 hrs. & trace wtr. TD 3309
S/ 7 boph 250A S/ 6 boph for 6 hrs.
POP

3/19 "

4/2 Spud 2-13-52

Oil Well TD 3309

8" @ 261

Anhy 445 Heeb. 2800

Br Li 2923 Lans. 2924

Cong. 3260 Arb. 3287

DST 3290-3301 open 1 hr. rec. 30' mud

TD 3303' 5" @ 3292 CO to 3303

DD 3304 20/3299-3304 3 go & wph

DD 3307 20/ 3293-98 55 A 9 bo


6 hr. DD 3309 S/ 7 boph 250 A

S/ 6 boph 6 hr. P/ 69 bo 3% wtr.

Comp. 75 bopd 4% wtr.

COMPLETED

County Rice State Kansas
 Sec. 34 (Blk. 18) (Sur. 10W) Map No.
 Operator Anderson-Prichard
 Well No. 2 Farm LaMunyon
 Elev. 1734 Location SW SE SW

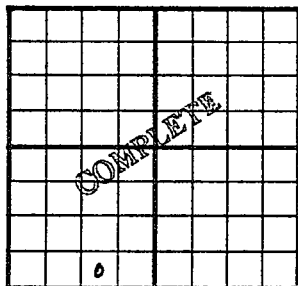

330 Ft. From S Line SW
990 Ft. From E Line Quarter
 1st. Report
 Completion APR 2 1952
 Remarks Munyon Pool
B & B Drlg. - Contr.
 Spudding Date 2-13-52

Drlg. Data Oil well TD 3309
8" @ 261 Anhy 445 Heeb. 2800
Br. lime 2923 Lans. 2924 Cong. 3260
Arb. 3287 DST 3290-3301 open 1 hr.
Rec. 30' mud TD 3303 5" @ 3292
CO to 3303 DD 3304 20/ 3299-3304
3 go & wph DD 3307 20/ 3293-98 55A
9 bo 6 hr. DD 3309 S/ 7 boph 250 A
S/ 6 boph 6 hr. P/ 69 bo 3% water
Comp. 75 boph 4% water

J. G. McGEHEE