


Map No. KANSAS Sec. 15 Twp. 26 R. 2^E

Well No. 2 - Hadlick Farm
Hayes et al Company

_____ Ft. from N. Line
317 Ft. from S. Line
885 Ft. from E. Line
_____ Ft. from W. Line

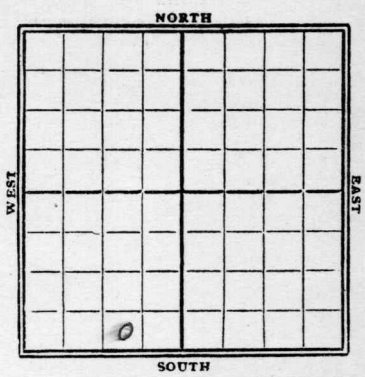

1929

Date	REPORT
7/24	Cellar
7/31	Bldg Rig
8/7	Rig up
8/14	wely 675
8/21	" 1480'
8/28	" 2236
9/4	" 2775
9/11	Chat 2905 show oil
	HFV 2930-70
	wely 3070
9/18	Simpson 1300-02'
	I.D. 1302'
	swab 300 bbl oil
	O show water
	son p.

Scotwick

Map No. **KANSAS** Sec. *15* Twp. *26* R. *2E*

13
Well No. *2 Nacllik*

Hays & Dal Company

Lot 3 Block 9 Contractor

SECTION PLAT

..... Ft. from N. Line

317 Ft. from S. Line

885 Ft. from E. Line

..... Ft. from W. Line

FIRST REPORTS

Location.....

Rig up.....

Drilling and Remarks:

Cellar

RECORD

Cased..... in., ft.

Sand.....

Gas.....

Oil.....

Total Depth.....

PRODUCTION

1st 24 hrs. Nat.....

1st 24 hrs. after shot.....

Gas..... Cu. Ft.

Dry Hole.....

Abandoned.....

Date

JUL 24 1929

192

S. J. LEWIS

Scout

Map No. 13 **KANSAS** Sec. 15 Twp. 26 R. 25

Well No. 2 Hadlik

Hayes & Co Company

Lot 3 Block 9 Contractor

Greenwich Township

SECTION PLAT

..... Ft. from N. Line

317 Ft. from S. Line

855 Ft. from E. Line

..... Ft. from W. Line

COMPLETED

Location.....

Rig up.....

Drilling and Remarks:

Simpson 3200-02

Swab 300 ft. oil
show water

RECORD

Cased..... in., ft.

Sand.....

Gas.....

Oil.....

Total Depth 3202

PRODUCTION

1st 24 hrs. Nat.....

1st 24 hrs. after shot.....

Gas..... Cu. Ft.

Dry Hole.....

Abandoned.....

Date

SEP 18 1929

S. J. LEWIS Scout