

Sec. 34 Twp. 18 R. 10W

Well No. #3 La Munyon Farm

Anderson & Prichard Company

Peel Bros. Contractor


_____ Ft. from N. Line

330 Ft. from S. Line

_____ Ft. from E. Line

990 Ft. from W. Line

SE SW SW

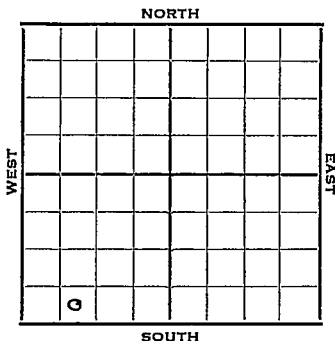

1952

Elev. 1735' REPORT

4/30

Spud 4-25-52

8" @ 218'

Drlg. 1705'

5/7

Spud 4-25-52

D & A TD 3395' 8" @ 218 Heeb 2807'

Br. line 2930' Lans. 2953' Cong. 328'

Arb. 3365'

TD 3395' D & A

ABANDONED

