

Rice

FORM 51

KANSAS

Section 34 Township 18 Range 10W

Well No. 2 Wessler

Company B & B Drlg

NORTH

						0	

SOUTH

WEST

EAST

KANSAS

Sec. 34 Rice Twp. 18 R. 10W

Well No. 2 Wessler Farm

B & B Drlg Company

Contractor


330 Orth Pool
Ft. from N. Line

Ft. from S. Line

990 Ft. from E. Line

Ft. from W. Line

NW NE NE

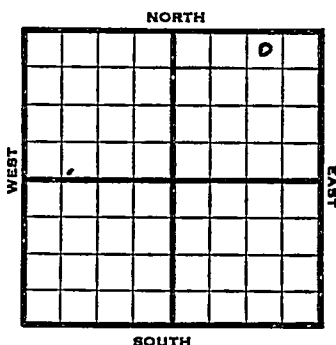

1953

Elev. 1736'

REPORT

4/1 Cellar & Pits
4/9 "
4/16 "
4/23 "
4/30 8" @ 197
Drlg. 3016'
5/7 Top 2480, Heeb 2745, Br. L. 2869, Lans
2888, B KC 3102, Cong 3158
DST 3192-3200 opn 1 hr, 34' M 520#
G 3220-24 2' G 3224-27 1'
G 3227-28½ 9" RTD 3245
5" @ 3245'
5/21 CO 3215 24/3211-15 Sd-frac.
P/77 BO plus 2 BWPD P/55 BO plus
4 BWPD
5/28 N.R.
6/10 Spud 4-20-53
Oil Well
TD 3245'
8" @ 197'
Top 2480, He b 2745, Br. Lime 2869
Lans 2888, B KC 3102, Cong 3158
DST 3192-3200 opn 1 hr, rec 34' mud
520#
TD 3245'

OVER

1953

Information brought forward.

6/10

5" @ 3245'

CO to 3215 24/ 3211-15 sd-frac

P/ 77 bo 2 bwpd

Comp. 55 bopd 4 bw

COMPLETED

County Rice State Kansas
 Sec. 34 (Blk.) 18 (Sur.) 10W Map No.
 Operator B & B Drlg.
 Well No. 2 Farm Wessler

Elev. _____ Location NW NE NE

330 Ft. From N Line NE

990 Ft. From E Line Quarter

1st. Report APR 1 1953

Completion _____

Remarks _____

Spudding Date _____

Drlg. Data _____

Orth Pool

Cellar & pits

J. G. McGEHEE

County Rice State Kansas
 Sec. 34 (Blk.) 18 (Sur.) 10W Map No.
 Operator B & B Drlg.
 Well No. 2 Farm Wessler
 Elev. 1736 Location NW NE NE

330 Ft. From N Line NE
 990 Ft. From E Line Quarter

1st. Report

Completion JUN 10 1953

Remarks Orth Pool

Spudding Date 4-20-53

Drig. Data Oil well TD 3245

8" @ 197 Top. 2480 Heeb. 2745

Br. lime 2869 Lans. 2888 B KC 3102

Cong. 3158 DST 3192-3200 open 1 hr.

Rec. 34' mud 520# TD 3245 5" @ 3245

CO to 3215 24/ 3211-15 sd-frac

P/ 77 bo 2 bwpd Comp. 55 bopd 4 bw

J. G. McGEHEE