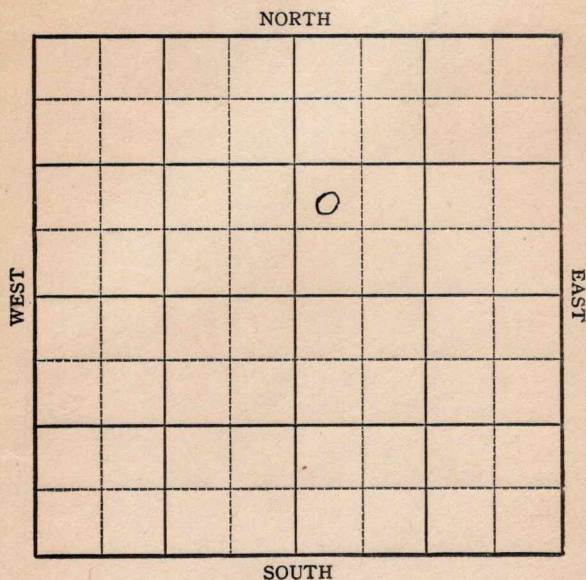


Section 27 Township 20 Range 12WWell No. 1 BryantCompany Alpine Oil & Royalty

KANSAS

Barton

Sec. 27 Twp. 20 R. 12W ✓

Well No. #1 Bryant Farm

Alphine Oil & Royalty Company

Wildcat


 Ft. from N. Line

990' Ft. from S. Line

 Ft. from E. Line

330' Ft. from W. Line

NW SW NE

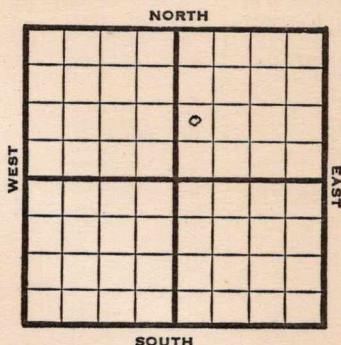

1948

Eli 1826'

R E P O R T

7/28

Location

8/4

8" @ 263'
Drlg. 2040'

8/11

Lansing 3151'
Arbuckle 3383'
TD 3385'
5" @ 3382'

8/18

"

8/25

TD 3400 1000 acid
Swb 3 bbls oil PH 9 hrs.

9/1

"

9/8

"

9/14

"

9/21

"

9/29

"

10/6

"

10/13

"

10/19

"

10/26

"

11/3

TD 3405'
2000 acid 1600' oil

11/10

"

11/16

"

11/23

"

11/30

"

OVER

1948
12/8

743950

TD 3405'

Arb. 3383'

5"@ 3382'

2000 acid

Pump 171 0.1 Pot

40² Gr.

Comp

COMPLETED

Barton County Kansas State

Map No. _____ Sec. 27 Twp. 20 R. 12W

Well No. 1 Bryant

Alpine Oil & Royalty Company

FIRST REPORT Contractor

NW SWNE


SECTION PLAT

_____ Ft. from N. Line

990 Ft. from S. Line

_____ Ft. from E. Line

330 Ft. from W. Line

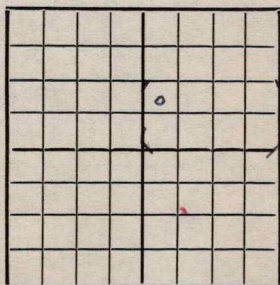

Wildcat

Remarks:

Location

Date
JUL 28 1948

Scout
S. J. LEWIS

Kansas

Bryant Pool

Map No. 46 Sec. 27 Twp. 20 R. 12WWell No. 1 BryantAlpine Oil & Royalty Company

COMPLETE

Contractor

NW SW NE

SECTION PLAT

 Ft. from N. Line990 Ft. from S. Line Ft. from E. Line330 Ft. from W. Line

Barton County

Location Rig up

Drilling and Remarks:

*Cs 4383**5" 4382**2000 Acid**Pump 171 oil Pt**40 2 1/2*

RECORD

Cased in., ft.Sand Gas Oil Total Depth 3705

PRODUCTION

1st 24 hrs. Nat. 1st 24 hrs. after shot Gas Cu. Ft.Dry Hole Abandoned

Date

DEC 8 1948

19

S. J. LEWIS

Scout