


Section 34 Township 18 Range 10WWell No. 3 MunyonCompany Carl Lebsack

NORTH

WEST

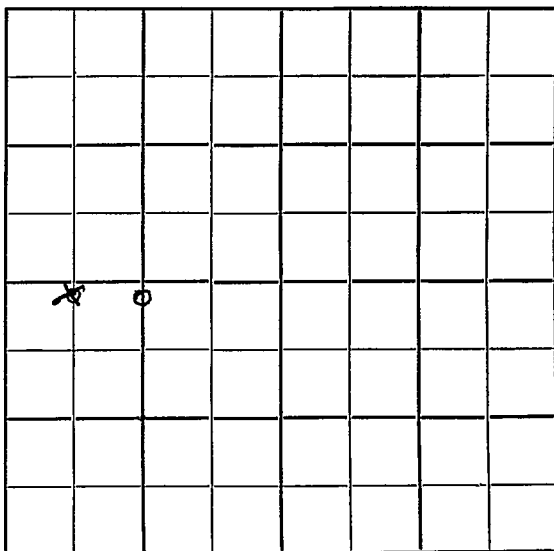

EAST

SOUTH

Rice

KANSAS

Sec. 34 Twp. 18 R. 10 W

Well No. # 3 Munyon Farm

Carl Lebsack Company

Stagg Contractor


330 Ft. from N. Line

 Ft. from S. Line

 Ft. from E. Line

1320 Ft. from W. Line

G N $\frac{1}{2}$ N $\frac{1}{2}$ SW

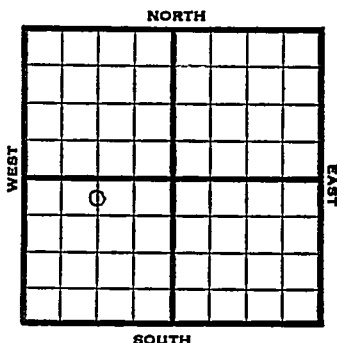

1951

Elev. 1735' REPORT


7/18

Spud 7-8-51
8" @ 124'
Heeb 2780' Lans. 2919'
Drlg. 2957'

9/5

Spud 7-8-51
Oil Well TD 3295
8" @ 124
Heeb. 2780
Lans. 2919
DS 2999-3004 opn $\frac{1}{2}$ hr.
Rec. 30' mud & sw
Arb. 3288-93 5" @ 3289
TD 3295 FU 1000' oil 6 hr.
Comp. 40 bopd

COMPLETED

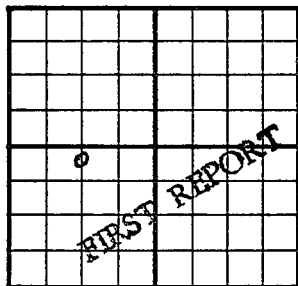County Rice State KansasSec. 34 (Blk.) 18 (Sur.) 10W Map No.Operator Carl LebsackWell No. 3 Farm MunyonElev. Location C. N $\frac{1}{2}$ N $\frac{1}{2}$ SW330 Ft. From N Line SW1320 Ft. From W Line Quarter1st. Report JUL 18 1951


Completion

Remarks

Stagg - Contractor.Spudding Date 7-8-51

Drlg. Data

8" @ 124 Heel 2780 Lans. 2919Ø 2957

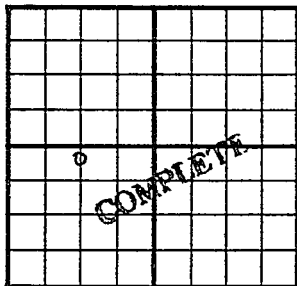County Rice State KansasSec. 34 (Blk.
Twp.) 18 (Sur.
Rge.) 10W Map No. _____Operator Carl LebsackWell No. 3 Farm MunyonElev. 1735 Location C N L N $\frac{1}{2}$ SW330 Ft. From N Line SW1320 Ft. From W Line Quarter

1st. Report _____

Completion SEP 5 1951

Remarks _____

Stagg Drlg. - Contr.Spudding Date 7-8-51Drlg. Data Oil well TD 32958" @ 124 Heeb. 2780 Lans. 2919DST 2999-3004 open $\frac{1}{2}$ hr. Rec. 30' mud.& sw Arb. 3288-93 5" @ 3289 TD 3295FU 1000' oil 6 hr. Comp. 40 bopd

J. E. TYRA