


Company Carl Lebsack

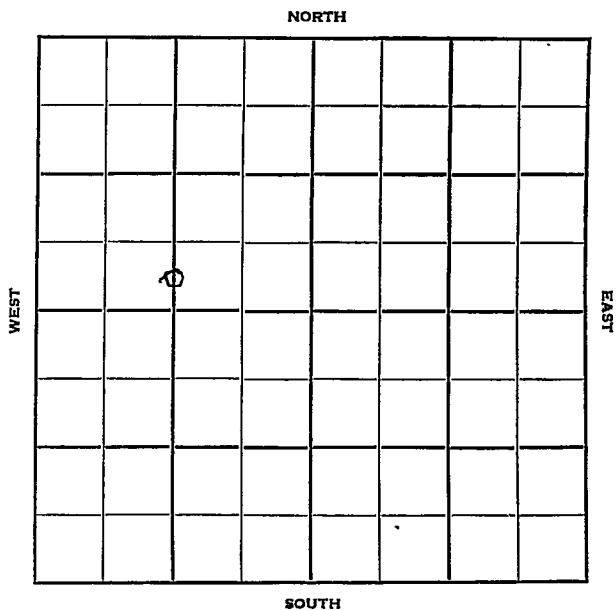

Rice

KANSAS

Sec. 34 Twp. 18 R. 10W

Well No. #1 Wesseler Farm

Car Lebsack Company

Stagg Drlg. - Contr. Contractor

Munyon Pool


 Ft. from N. Line

330' Ft. from S. Line

 Ft. from E. Line

1320' Ft. from W. Line

C S L S $\frac{1}{2}$ NW

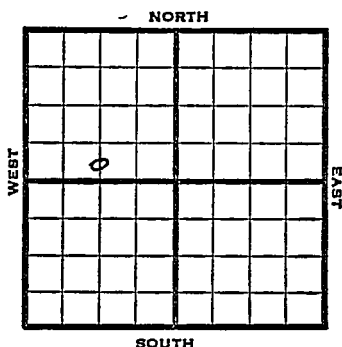


1951 Elev. 1734' REPORT

11/21 MIR

1952
1/9 Spud 11-19-51
Oil Well TD 3324
8" @ 132
Arb. 3307
5" @ 3310
TD 3324 500A
Regan Sand 3314
Comp. 25 bopd 4 bw

COMPLETED

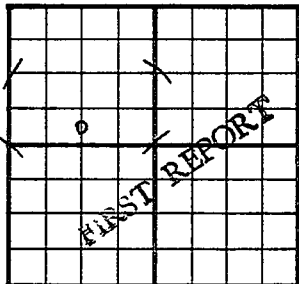County Rice State KansasSec. 34 (Blk. Twp.) 18 (Sur. Rge.) 10W Map No. 1Operator Carl LebsackWell No. 1 Farm WesselerElev. _____ Location C S 1. S $\frac{1}{2}$ NW330 Ft. From S Line NW1320 Ft. From W Line Quarter1st. Report NOV 21 1951

Completion _____


Remarks _____

Stagg Drlg. - Contr.

Spudding Date _____

Drlg. Data Munyon PoolM I R

J. E. TYRA

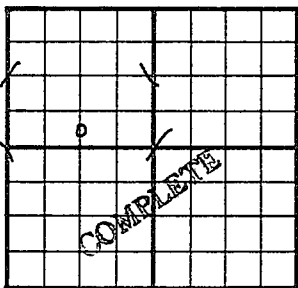County Rice State KansasSec. 34 (Blk. 18) (Sur. 10W) (Twp. 18) Map No.Operator Carl LebsackWell No. 1 Farm WesselerElev. 1734 Location C S L S $\frac{1}{2}$ NW330 Ft. From S Line NW1320 Ft. From W Line Quarter

1st. Report

Completion JAN 9 1952Remarks Munyon PoolStagg Drlg. - Contr.Spudding Date 11-19-51Drlg. Data Oil well TD 33248" @ 132 Arb. 3307 5" @ 3310 TD 3324500 A Regan sand 3314 Comp. 25 bopd 4 b

J. E. TYRA