


Section 34 Township 18 Range 10W

Well No. #1 Wessler

Company Bennett & Roberts.

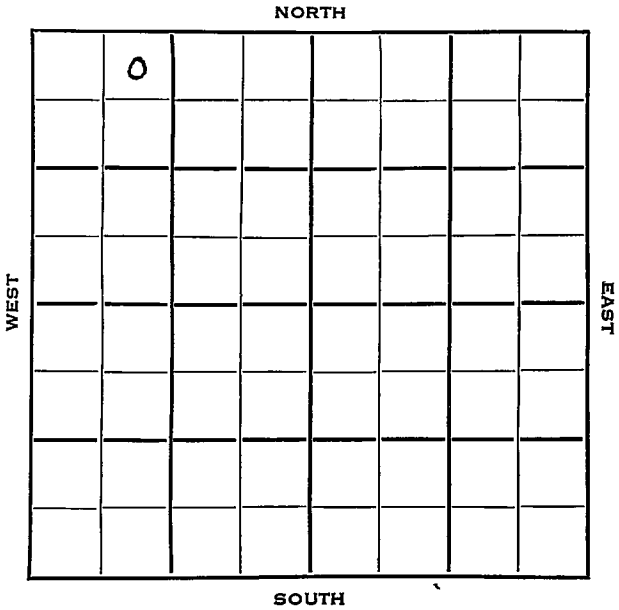



Sec. 34 Twp. 18 R. 10W

Well No. #1 Wessler Farm

Bennett & Roberts Company

B & R Drlg. Contractor

Munyon Pool


330 Ft. from N. Line

_____ Ft. from S. Line

_____ Ft. from E. Line

990 Ft. from W. Line

NE NW NW

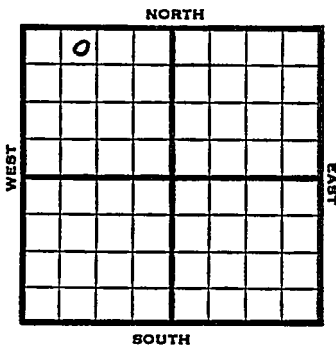

1953

Elev. 1748' REPORT

4/22 Spud 4-20-53
4/30 10" @ 177 Anhy 410'
Drlg. 2111'

5/7 Top 2456
DST 2667-86 opn 1 hr, 135' gas, 45' ocm
150# Heeb 2721, Br. L. 2842, KC 2858,
DST 3202-10' opn 1 1/4 hr, 180' gas,
55' Socm 620#
DST 3210-15 opn 2 1/4 hr, 100' clean oil,
50' ocm, 840' gas, 240#
RTD 3215
7" @ 3211'

5/21 NR

5/28 "

6/10 Spud 4-20-53
D & A
TD 3245'
10" @ 177'
Anhy 410, Top 2456,
DST 2667-86 opn 1 hr, rec 135' gas
45' ocm 150# Heeb 2721, Br. Lime
2842, KC 2858
DST 3202-10 opn 1 1/4 hr, rec 180' gas,
55' socm 620#
DST 3210-15 opn 2 1/4 hr, rec 100' clean
oil, 50' ocm, 840' gas 740#
TD 3245'

OVER

1953

Information brought forward.

6/10

7" @ 3211'

CO to 3245

HFV

D & A

ABANDONED


County **Rice** State **Kansas**

Sec. **34** (Blk. Twp.) **18** (Sur. Rge.) **10W** Map No.

Operator **Bennett & Roberts**

Well No. **1** Farm **Wessler**

Elev. Location **NE NW NW**

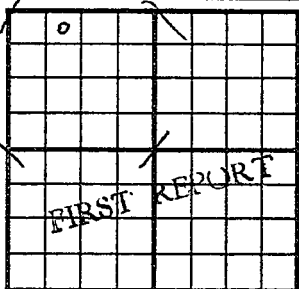

330Ft. From **N** Line **NW**

990Ft. From **W** Line **Quarter**

Ist. Report **APR 22 1953**


Completion

Remarks

B & R Drlg. - Contr.

Spudding Date **4-20-53**

Drlg. Data **Munyon Pool**

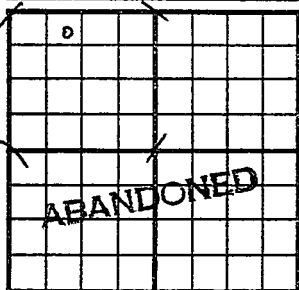County Rice State KansasSec. 34 (Blk. Twp.) 18 (Sur. Rge.) 10W Map No.Operator Bennett & RobertsWell No. 1 Farm WesslerElev. 1748 Location NE NW NW330 Ft. From N Line NW990 Ft. From W Line Quarter

1st. Report

Completion JUN 10 1953Remarks Munyon PoolB & R Drlg. - Contr.Spudding Date 4-20-53Drlg. Data D & A TD 324510" @ 177 Anhy. 410 Top. 2456DST 2667-86 open 1 hr. Rec. 135' gas45' ocm 150# Heeb. 2721 Br. lime 2842KC 2858 DST 3202-10 open 1½ hr.Rec. 180' gas 55' socm 620#DST 3210-15 open 2½ hr. Rec. 100' cleanoil 50' ocm 840' gas 740#TD 3245 7" @ 3211 CO to 3245 HFWD & A