
FORM 51 25M 8-50 WESTERN

Rice KANSAS

Section 34 Township 18 Range 10 W

Well No. # 1 Wessler

Company B & B Drlg. Co.

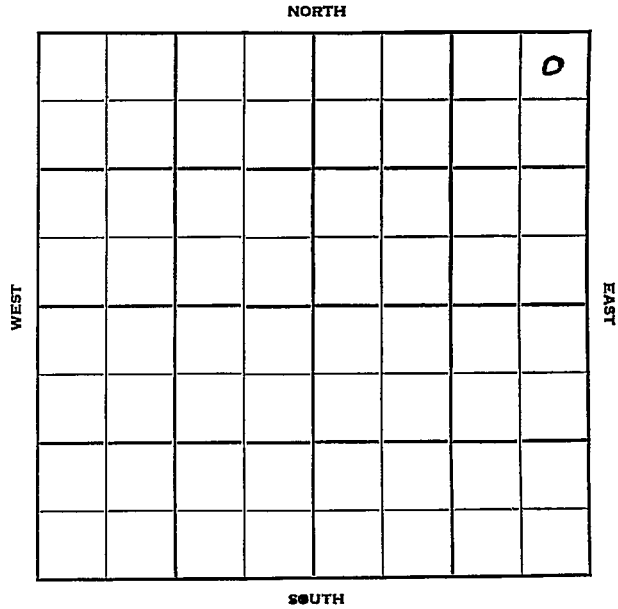

FORM 252-B
10M 8-51 TPCO. Rice

KANSAS

Sec. 34 Twp. 18 R. 10W

Well No. #1 Wessler Farm

B & B Drlg. Co. Company

B & B Drlg. - Contr. Contractor


330 Ft. from N. Line

Ft. from S. Line

330 Ft. from E. Line

Ft. from W. Line

NE NE NE

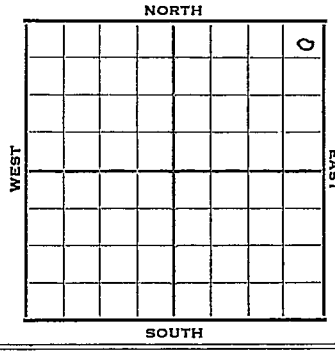

1952	Elev. 1741 REPORT
6/25 7/2	RU 8" @ 180 Drlg. 2875'
7/9	Anhy 420 Topeka 2451 Heeb. 2717 Br Li 2833 Lans. 2854 DST 3037-55 1/2 hr. 600' & 60' HOCM 900# RTD 3137 5" @ 3137 DD 3147 SSO
7/16	Spud 6-24-52 Oil Well TD 3157 8" @ 180 Anhy 420 Top 2451 Heeb. 2717 Br Lm 2833 Lans. 2854 DST 3037-55 opn ½ hr. Rec. 60' oil & 60' hocm 900# TD 3137 5" @ 3137 DD 3147 SSO DD 3157 1 boph Hydro S/9 boph 5 hrs. Comp. 50 bopd

COMPLETED

FORM 275 FOR SALE BY KANSAS BLUE PRINT CO.


County Rice State Kansas

Sec. 34 (Blk. Twp.) 18 (Sur. Rge.) 10W Map No.

Operator B & B Drlg. Co.

Well No. 1 Farm Wessler

Elev. Location NE NE NE

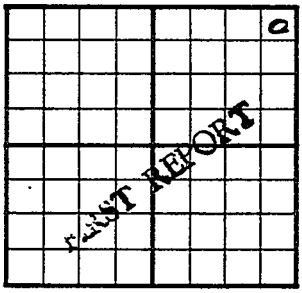

330 Ft. From N Line NE

330 Ft. From E Line Quarter

1st. Report JUN 25 1952

Completion

Remarks B & B Drlg. - Contr.

Spudding Date

Drlg. Data

RU

J. G. McGEHEE

FORM 275 FOR SALE BY KANSAS BLUE PRINT CO.


County Rice State Kansas

Sec. 34 (Blk. Twp.) 18 (Sur. Rge.) 10W Map No.

Operator B & B Drlg.

Well No. 1 Farm Wessler

Elev. 1741 Location NE NE NE

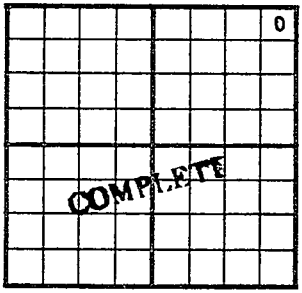

330 Ft. From N Line NE

330 Ft. From E Line Quarter

1st. Report

Completion JUL 1 6 1952

Remarks

B & B Drlg. - Contr.

Spudding Date 6-24-52

Drlg. Data Oil well TD 3157

8" @ 180 Anhy 420 Top. 2451

Heeb. 2717 Br. lime 2833 Lans. 2854

DST 3037-55 open ½ hr. Rec. 60' oil

& 60' hocm 900# TD 3137 5" @ 3137

DD 3147 • SSO DD 3157 1 boph

Hydro. S/ 9 boph 5 hr.

Comp. 50 bopd

J. G. McGEHEE