


Section 1 Township 18 Range 11-W

Well Number 2 Mueller

Company Magnolia

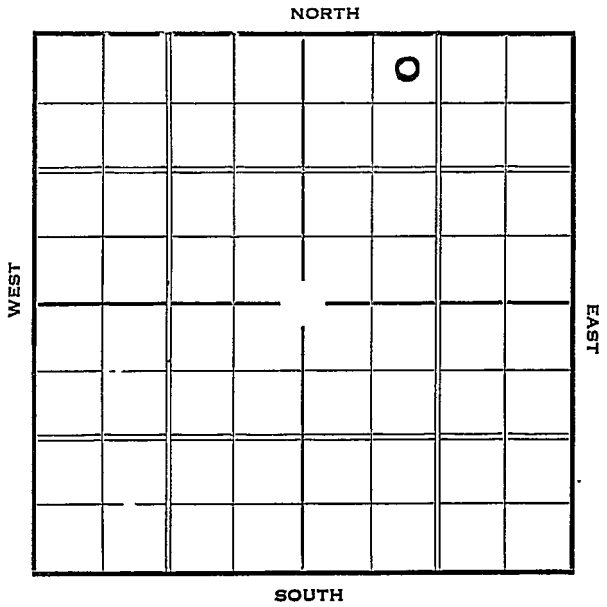

Sec. 1 Twp. 18 R. 11-W

Well No. #2 Mueller Farm

Magnolia Company


330 Ft. from N. Line

_____ Ft. from S. Line

_____ Ft. from E. Line

990 Ft. from W. Line

Elev. 1806

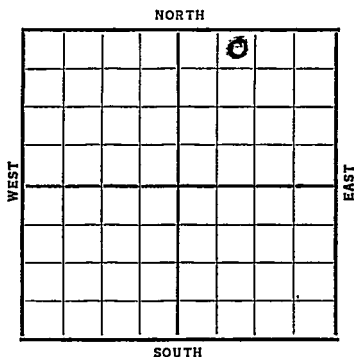

| Date | REPORT |
|------|--|
| 1937 | |
| 4/7 | Rig |
| 4/16 | 13" @ 204'. WOC. |
| 4/23 | Drlg. 2700'. |
| 4/30 | Sil. ³²⁴⁸ / 3255 ' . 7" @ 3252'. |
| | T.D. 3255'. RUST. |
| 5/7 | Sil. ³²⁴⁸ / 3250 ' (Corrected) |
| | |
| | |
| 5/12 | Sil. 3248' (Corrected') |
| | T.D. 3259'. |
| | Pot. 1497 bbls. 24 hrs. |
| | Natural. |
| | |
| | COMPLETED |
| | |
| | |
| | |
| | |
| | |
| | |
| | |
| | |
| | |

KANSAS *Barton*

Map No. _____ Sec. 1 Twp. 18 R. 11W

Well No. 2. Mueller

Magnolia Company

Contractor

SECTION PLAT

| | | | |
|--|--|---|--|
| | | 0 | |
| | | | |
| | | | |
| | | | |

330 Ft. from N. Line

_____ Ft. from S. Line

_____ Ft. from E. Line

990 Ft. from W. Line

FIRST REPORT

Location _____

Rig up _____

Drilling and Remarks:

Rig

RECORD

Cased _____ in., _____ ft.

Sand _____

Gas _____

Oil _____

Total Depth _____

PRODUCTION

1st 24 hrs. Nat. _____

1st 24 hrs. after shot _____

Gas _____ Cu. Ft.

Dry Hole _____

Abandoned _____

Date

APR 7 1937 19

S. J. LEWIS Scout

Barton KANSAS

Map No. 55 Sec. 1 Twp. 18 R. 11 WWell No. 2-MuellerMagnolia Company

Contractor

COMPLETED**SECTION PLAT**

| | | | |
|--|--|---|--|
| | | 0 | |
| | | | |
| | | | |
| | | | |

330 Ft. from N. Line

_____ Ft. from S. Line

_____ Ft. from E. Line

990 Ft. from W. Line

Location _____

Rig up _____

Drilling and Remarks:

Pot. - 1497/24 hrs.
 NAT.

RECORD

Cased _____ in., _____ ft.

Sand sil - 3248 (Corrected)

Gas _____

Oil _____

Total Depth 3259**PRODUCTION**

1st 24 hrs. Nat. _____

1st 24 hrs. after shot _____

Gas _____ Cu. Ft.

Dry Hole _____

Abandoned _____

Date

MAY 12 1937 19

H. D. Hatfield

Scout