

KANSAS


FORM 51 5M 2-38 TPCO.

Barton

Section 1 Township 18 Range 11-W

Well No. 5 Mueller

Company Magnolia

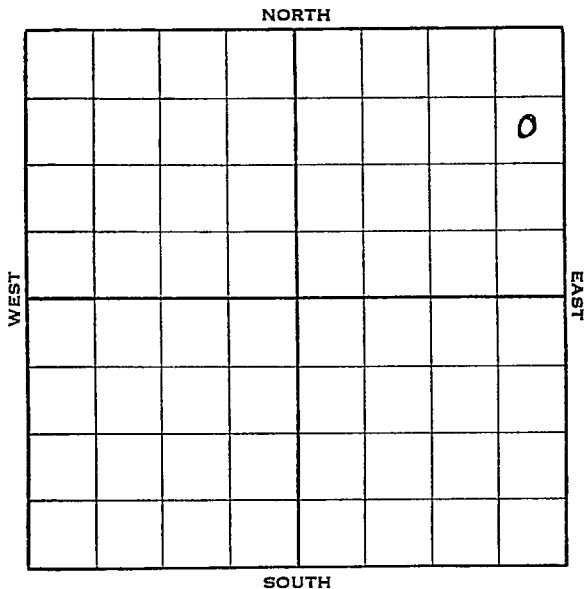

Sec. 1 Twp. 18 R. 11-W

Well No. #5 Mueller Farm


Magnolia Company

990 Ft. from N. Line

_____ Ft. from S. Line

330 Ft. from E. Line

_____ Ft. from W. Line

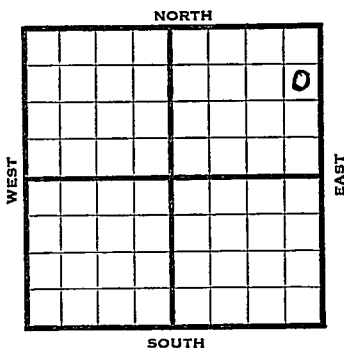

Elev. 1802'

1938	REPORT
9/14	Gellar.
9/23	R U R
9/30	13" - 211'. Dlg. 1600'.
10/7	Drlg. 2890'.
10/14	Arb. 3240'. 7" - 3240'.
	T. D. 3242'. 950' oil 5 hrs.
10/20	7" - 3240'.
	Arb. 3240'.
	T. D. 3249'.
	Potential 1605 bbls. Nat'l.
	COMPLETED

Barton

KANSAS

Map No. 55 Sec. 1 Twp. 18 R. 11WWell No. 5 MuellerMagnolia

Company

Contractor

FIRST REPORT

SE NE NE

990 Ft. from N. Line

_____ Ft. from S. Line

330 Ft. from E. Line

_____ Ft. from W. Line

SECTION PLAT

			①
			/

Location _____

Rig up _____

Drilling and Remarks:

Cellar

RECORD

Cased _____ in., _____ ft.

Sand _____

Gas _____

Oil _____

Total Depth _____

PRODUCTION

1st 24 hrs. Nat. _____

1st 24 hrs. after shot _____

Gas _____ Cu. Ft.

Dry Hole _____

Abandoned _____

Date

SEP 14 1938

19

H. D. Hatfield Scout

Barton

Map No. _____ Sec. 1 Twp. 18 R. 11W

Well No. 5 Mueller

Magnolia Company

Contractor

COMPLETED

990 SE NE NE
Ft. from N. Line

_____ Ft. from S. Line

330 Ft. from E. Line

_____ Ft. from W. Line

SECTION PLAT

			0

Location _____

Rig up _____

Drilling and Remarks:

POT 1605
NET

RECORD

Cased 7 in. 3240 ft.

Sand Arb 3240

Gas _____

Oil _____

Total Depth 3249

PRODUCTION

1st 24 hrs. Nat. _____

1st 24 hrs. after shot _____

Gas _____ Cu. Ft.

Dry Hole _____

Abandoned _____

Date

OCT 19 1938 19

H. D. Hatfield Scout